

June 24, 1961

Section Corner 28-29-32-33,

T30S RAW W.M. as det. by OBT.

42" Fir N79E 89⁸' dist. OBT.

32" Dead Fir N68W 46³' dist. OBT.

40" Dead Fir S89W 55⁸' dist. OBT.

At cor. pt. fld stone & set
3/4" x 30" I.P.

From which


9" La. bears N64W 12⁶' dist. mkd.

S 29 T30S RAW B.T.

10" Fir N47E 6⁵' mkd. S 28 B.T.

17" Fir S31E 9³' mkd. S 33 B.T.

Witness: J. L. Markham

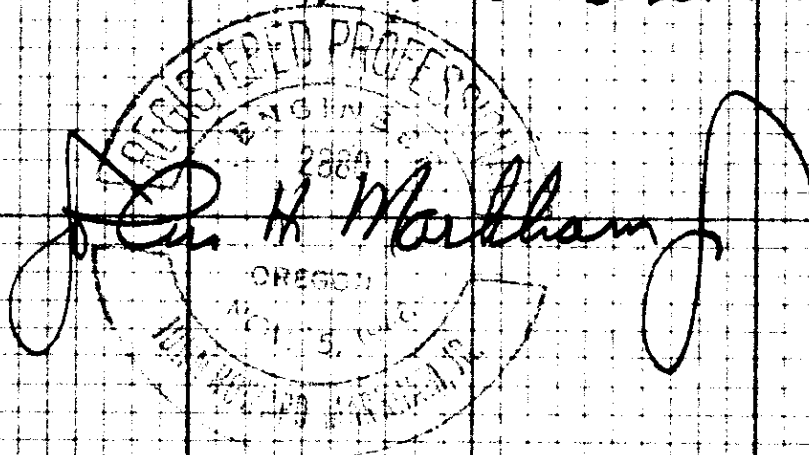

A circular professional seal for a Registered Professional Engineer in Oregon. The seal contains the text: "REGISTERED PROFESSIONAL ENGINEER", "No. 2889", "J. L. Markham", "OREGON", and "MAY 15, 1956". A large, stylized signature of "J. L. Markham" is written across the seal.

Work done for Stroman, Lbr Co. 20
C.S. 42/356