

South line section 32, T25S, R7W


Beginning at the corner of sections 32, 33 T25S, R7W and sections 4, 5, T26S, R7W w.m.; which is a post and is witnessed by two original witness trees, one being a fir that bears N70°E 28 links, with the bark scribe still visible, the other being a fir that bears N50°W 60 links. The fir that bears S70°E 71 links is down but scribe marks are visible. The fir that bears S85°W 140 links, is also down; thence I run west on a variation of 20°30'E and at station 9+83 cross a ridge top that runs north and south, at station 19+40 cross small creek, at station 21+32 cross another small creek at station 26+40 and vicinity I could find no evidence of the 1/4 corner, this area having been badly burned about 50 or 60 years ago, at station 52+47 I renew the corner of sections 31, 32 T25S, R7W, and sections 5, 6 T26S, R7W, from the evidence of intersecting blazed lines, an uprooted 24" cedar line tree to the west, a ridge top and creek call to the north, and stump holes of original witness trees that fit for bearing and distance. Then at the proportionate distance 2635.8 feet East from the southwest corner of section 32, I set the 1/4 corner for section 32 T25S, R7W and section 5 T26S, R7W, a fir post from which a 30" fir bears S33°E 8.0 feet

Marked 1/4 S 5 BT

a 1 1/2" Madrone bears N18 1/2°W 12.9 feet

Marked 1/4 S 32 T25S, R7W 2807

2/21/58

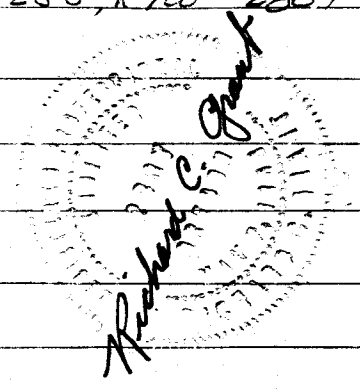

FILED RECEIVED

JUN 24 1958

COUNTY SURVEYOR DOUGLAS COUNTY, ORE.