
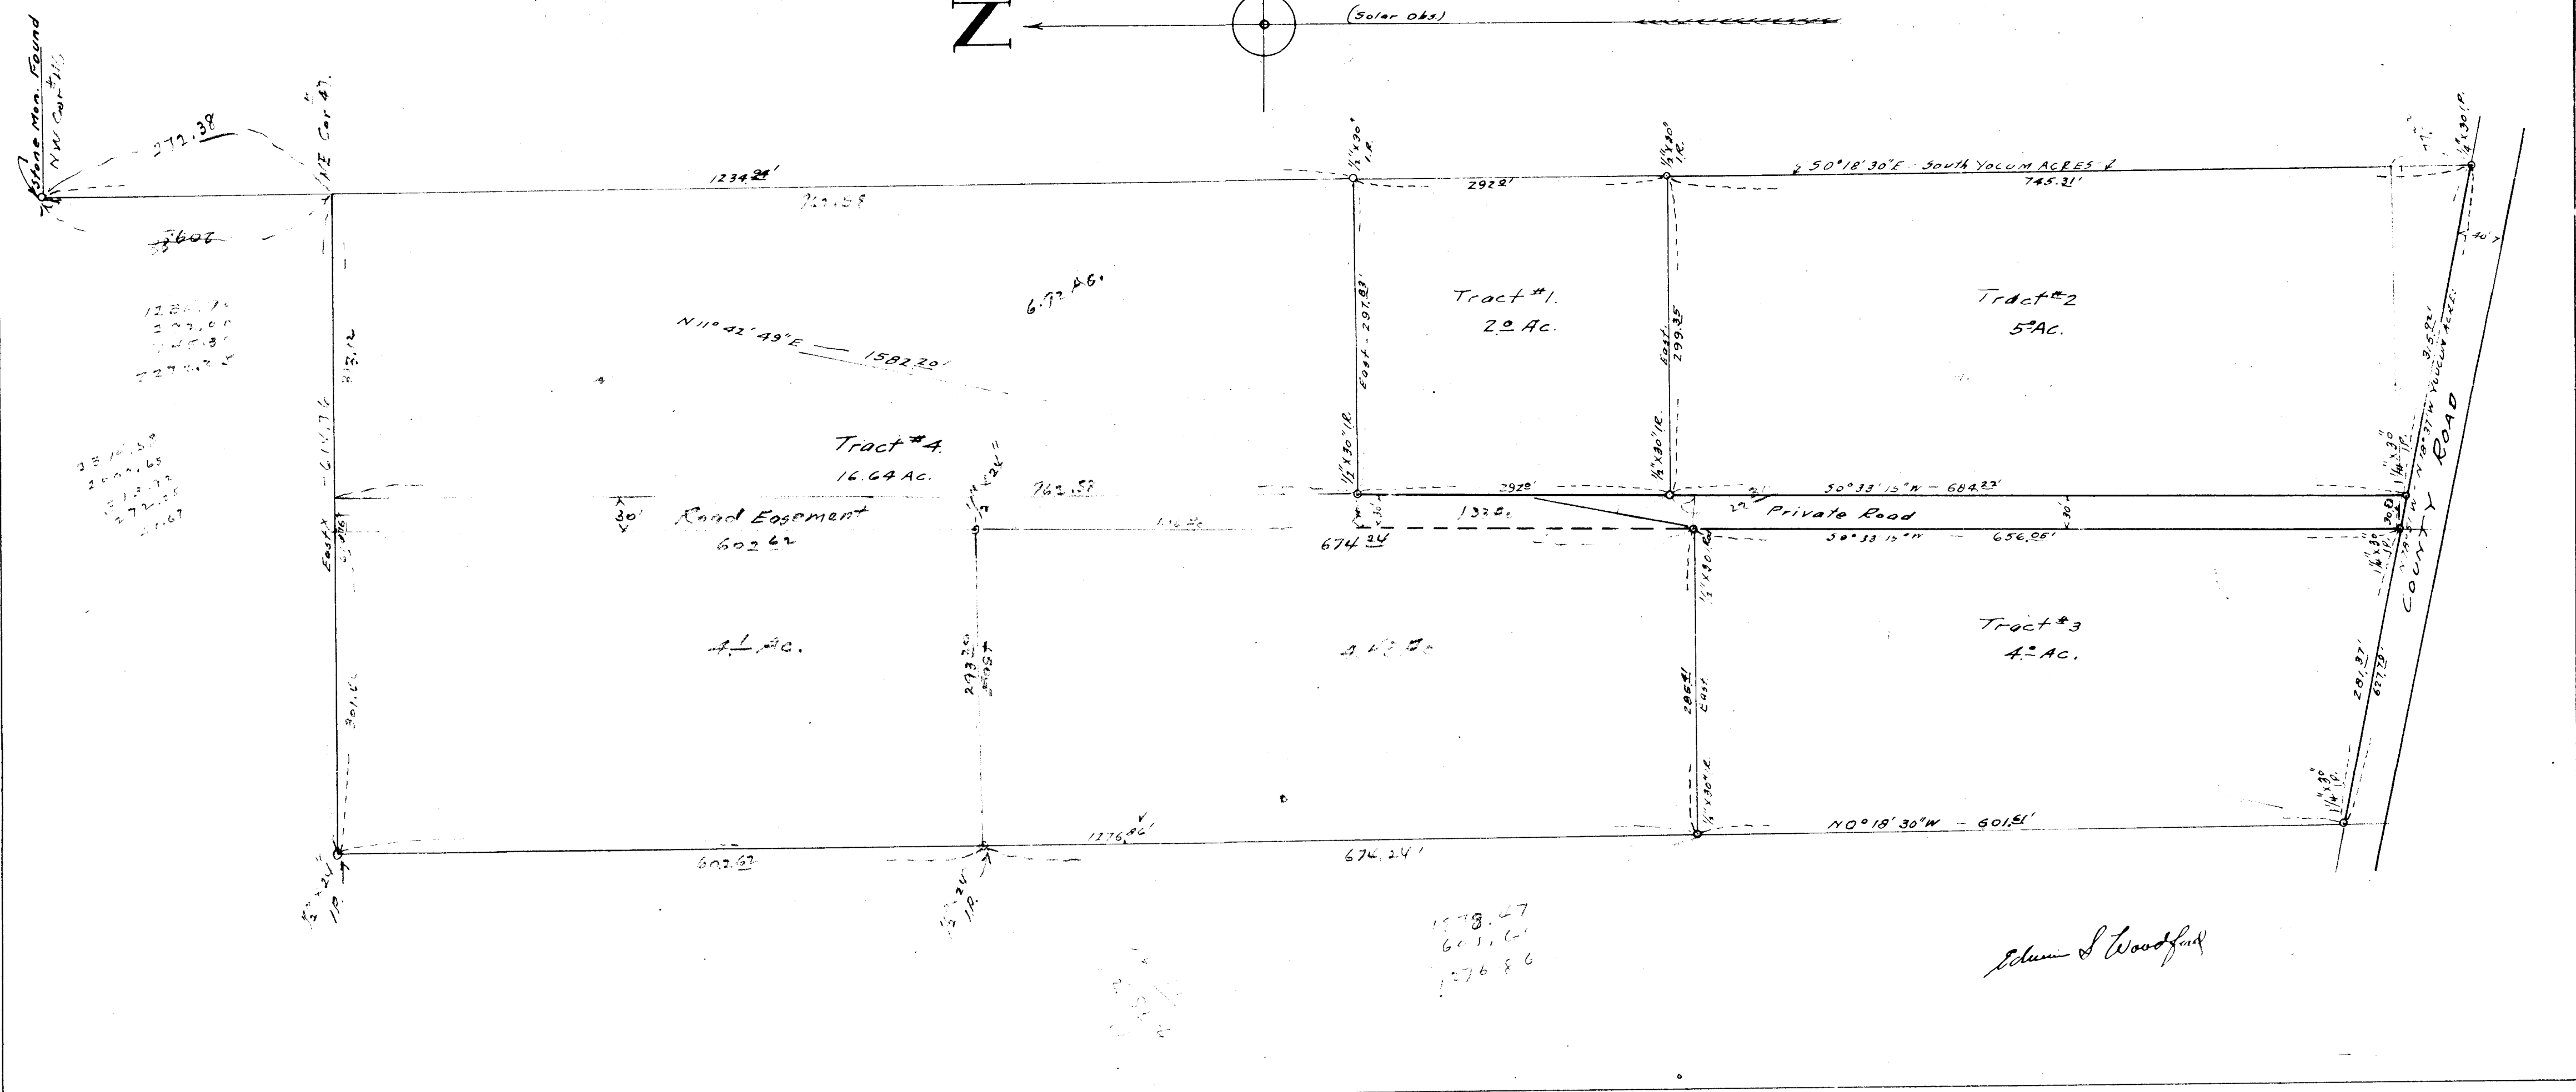


COUNTY SURVEYORS FILE DATA
DO NOT REMOVE FROM OFFICE

MAP
SHOWING LANDS SURVEYED.
IN
LOTS 2-3 BLOCK-I
GLENGARY FRUIT LANDS
SCALE-1"=100'

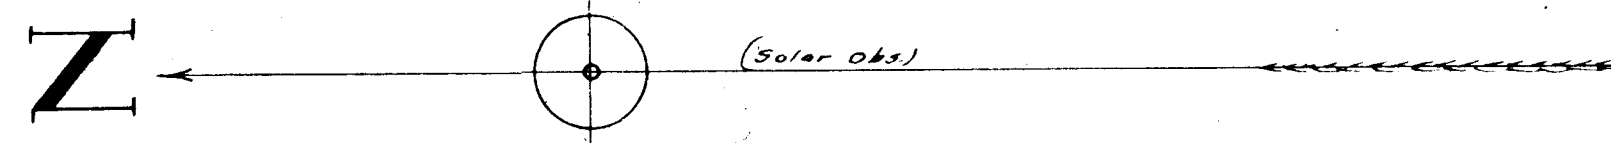

Edwin S. Woodford