

July 22, 1958

Renewal of Sec. Cor. 2, 3, 10, 11

T30S R5W W.M. as determined

by O.B.T.'s

26" B. Oak N65°W 75 ft.

26" P. Pine S37°W 82 ft.

22" B. Oak N46°E 31 ft.

At corner found original stone
and set 1" x 30" I.P.

from which:

5" Madrone bears N51°E 20.0' Dist.

Mkd. SE B.T.

6" Mad. N17°E 32.0' Dist.

Mkd. S 2 X B.T.

9" Mad. N19°W 26.8' Dist

Mkd. S 3 B.T.

10" Mad. S78°W 65.0' Dist

Mkd. S10 R5W B.T.

7" Mad. S26°E 13.0' Dist.

Mkd. S H T30S B.T.


Old fence bears S70°E & N70°W Through Cor.

Cor. lies on nose of east ridge.

Witnesses:

V E ESSary

J. H. Markham Jr.

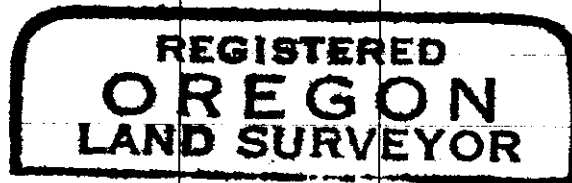

Burton W. Holt

