

Feb. 26, 1959

C.S. $\frac{1}{16}$ corner Section 24, T31S
R4W, W.M.


At corner point set $\frac{3}{4}$ " x 30" I.P.
from which

6" Hemlock bears S70W 15.5'
dist. mkd. $\frac{1}{16}$ S24 B.T.

65" Fir bears S11W 21.7' dist.
mkd. on bark $\frac{1}{16}$ S24 B.T.

$\frac{5}{4}$ cor. Sec 24 bears South 1307.0'

Witness: R. G. Boyd

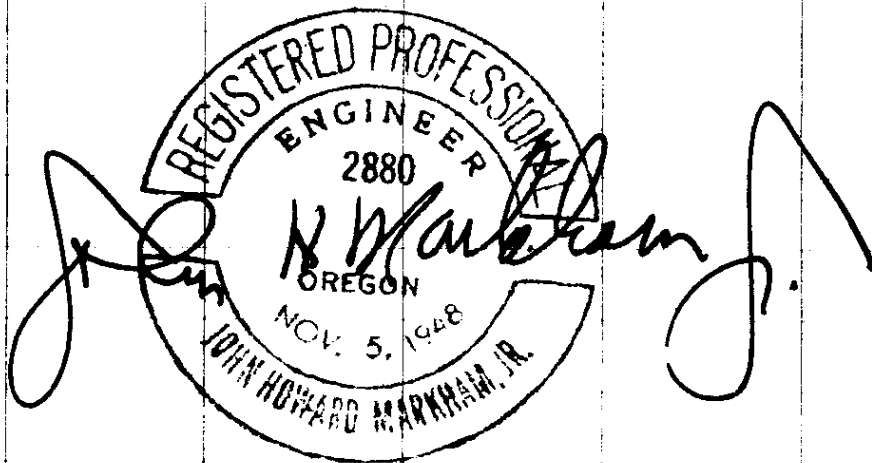

Work done for Stoman Lbr. Co.

✓ C. S. File No. 42/391-154