

March 6, 1959


• $\frac{1}{16}$ corner = Center of NE $\frac{1}{4}$
Section 10, T31S, R4W, W.M.

At cor. pt. set $\frac{3}{4}$ " x 30" I.P.
From which

30" Cedar bears N33E 5.5'
dist. mkd $\frac{1}{16}$ S 10 B.T.

9" La. bears S17W 21.0 dist.
mkd. $\frac{1}{16}$ S 10 B.T.

• Witness: R. G. Boyd

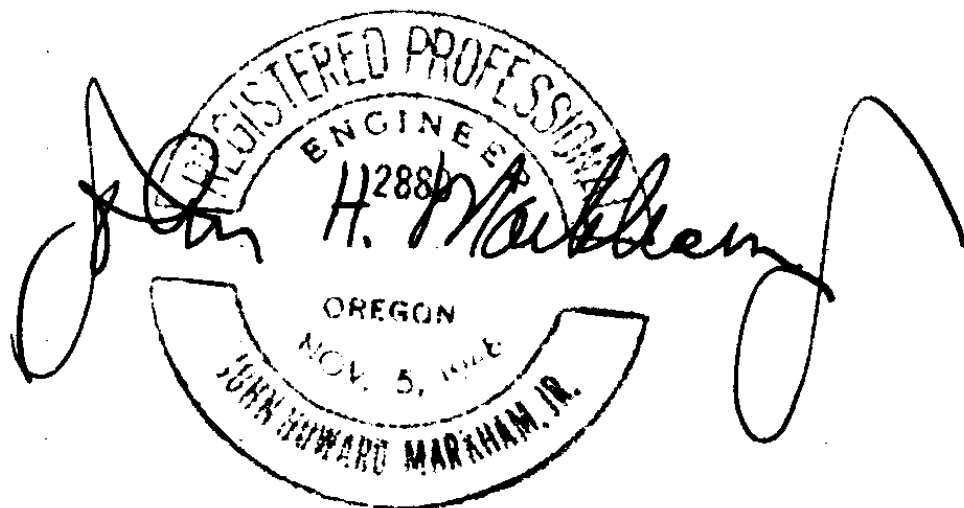

• Work done for Starna Lbr. Co.

✓ C. S. File No. 42/391-18