

April 28, 1959

Center of NE $\frac{1}{4}$ Section 24,

● T315 RAW W.M.

At $\frac{1}{16}$ corner set $3\frac{3}{4} \times 30$ " I.P.

From which


4" Live Oak bears S56°W

15.8' dist. mkd. $\frac{1}{16}$ S 24 B.T.

60" Fir bears S25E 21.3'

dist. mkd. $\frac{1}{16}$ S 24 B.T.

Witness: R. G. Boyd.

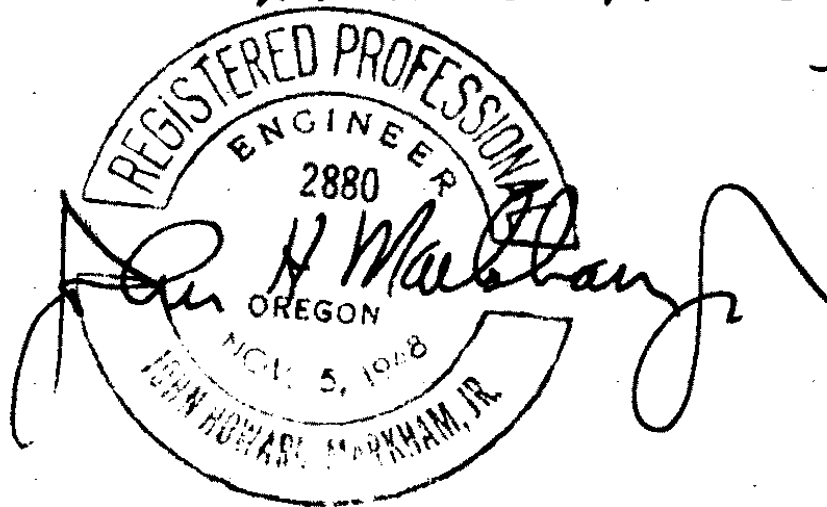

Work done for Stoman Lbr. Co.

✓ C.S. File No. 42/391-23