

Sept. 22, 1959

1/4 Corner 12-13, T31S R4W
W.N.T. as det. by O.B.T.

15" Fir bears N53W 25.0
found scribe O.B.T.

At corner point set 3/4" x 30" I.P.
from which


5" La. bears N67E 23.0'
dist. mkd. 1/4S 12 B.T.

14" La. bears S73W 27.0'
dist. mkd. 1/4S 13 T31S R4W B.T.

16" Fir bears S46W 44.0'
dist. mkd. 1/4S 13 B.T.

Corner lies in small draw

Witness: R. G. Boyd

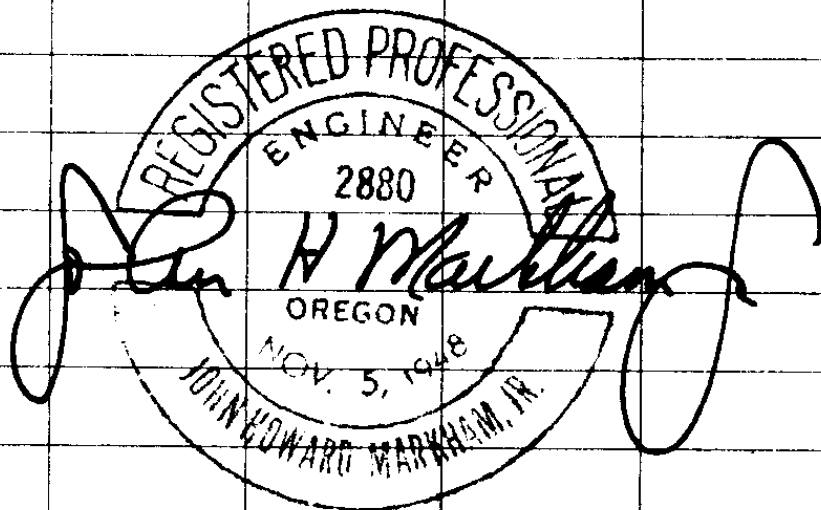

Work done for Stearns Lbr. Co.

✓ C. S. File No. 72/391-A