

Sept 22, 1959

N.E. Corner Section 13, T31S

R4W, W.M. as det. by O.B.T.s.

32" Fir S32W 70.3' O.B.T. fd. scribe.

36" Fir S8E 90.0' O.B.T.

44" Fir N26E 47.5' O.B.T.

32" Fir N84W 46.0' O.B.T.

At corner point found stone  
and set  $3\frac{1}{4} \times 30$ " I.P.

from which


7" Fir bears N6E 14.9' dist.  
mkd. S12 B.T.

7" Cedar bears N40E 22.2' dist.  
mkd. S7 T31S R3W B.T.

15" Fir bears S70E 7.0' dist.  
mkd. S18 R3W B.T.

6" Lg. bears S14W 30.0' dist.  
mkd. S13 T31S R4W B.T.

Witness: R.G. Boyd

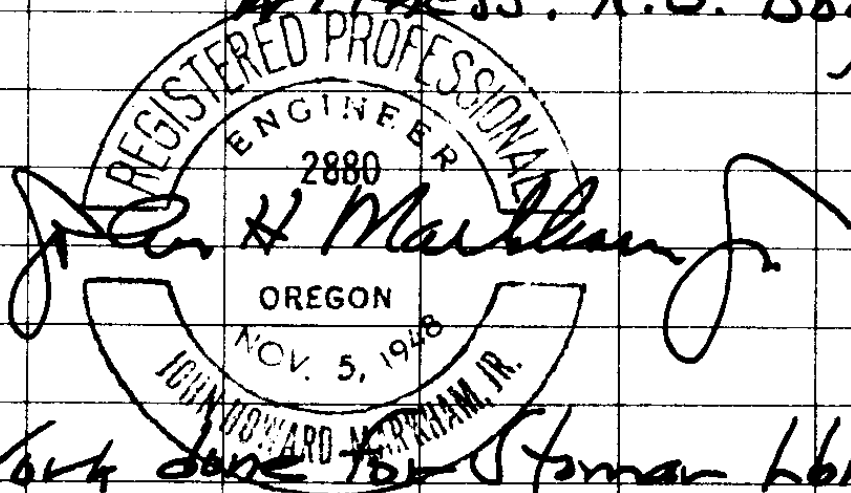

Work done for Stoman Lbr. Co.

C. S. File No. 92/391-42