

Sept. 22, 1959

East $\frac{1}{4}$ Corner Section 13,

T31S R4W N.M. as det. by O.B.T.

40" Fir 566 E 33.0' O.B.T.

36" Fir 548 W 17.4' O.B.T.

At corner point set $1\frac{1}{2} \times 30$ " I.P.
from which

8" Fir bears S20W 26.0'

dist. mkd. '45 13 B.T.

7" Fir bears N84E 23.6'


dist. mkd. '45 18 B.T.

11" Fir bears N29E 24.0' dist.

mkd. '45 18 B.T.

Shively Creek bears South 100.0'

Witness: R. G. Boyd

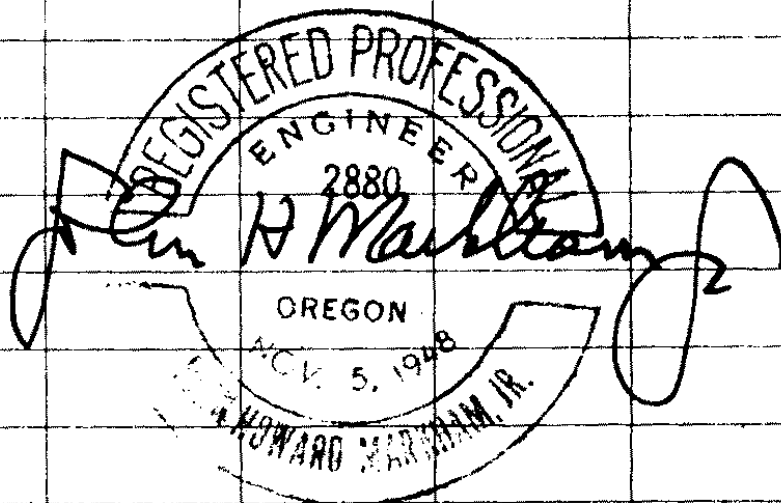

Work done for Starnan Lbr Co.

✓ C. S. File No. 42/391A³