

Sept. 24, 1959

1/4 Corner 11-12 T315 RAW
W.M.

At midpoint set 3/4 x 30" I.P.
from which

5" La. bears N83E 32.0'

dist. mkd. '14512 T315 B.T.

5" La. bears S37W 8.3' dist.

mkd. '14511 T315 R4W B.T.


5" La. bears S67W 7.1' dist.

mkd. '14511 B.T.

S.W. Corner 12 bears South 2596'

N.W. Corner 12 bears North 2596'

Witness: P.G. Boyd

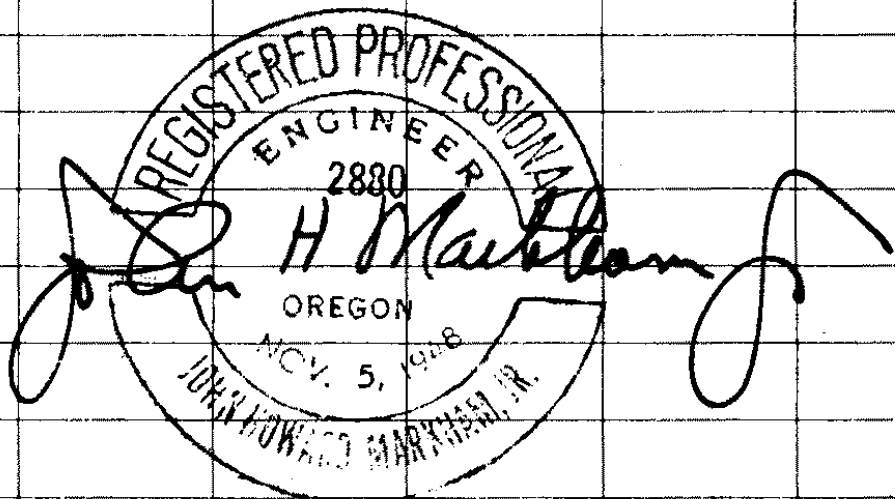

Work done for Starnon Lamb

✓ C. S. File No. 42/391-45