

Nov. 5, 1957

1/4 Corner 14/23 T315 RAW
W.M. as det. by O.B.T.s.

36" Fir S60E 30.0' O.B.T.

24" Fir S74q N25W 17.8' O.B.T.

At corner point set $\frac{3}{4}$ " x 40" I.P.
From which

36" Fir bears S1°E 61.6'
dist. mkd. 14523 B.T.

40" Fir bears S3°E 30.6'
dist. mkd. 14523 T315 RAW B.T.

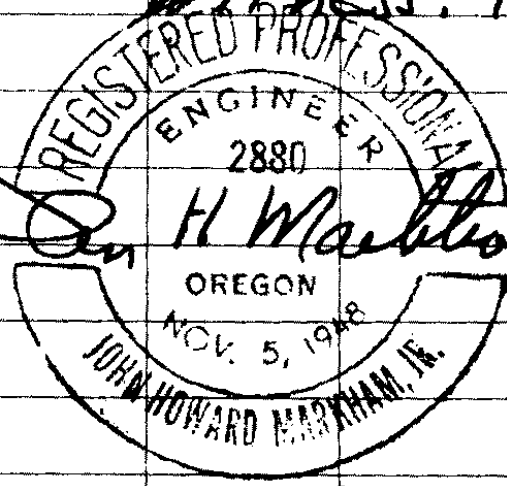
24" Fir bears S82E 29.7' dist.
mkd. 14523 x B.T.

Sec. Cor. bears West 2664.0'

Sec. Cor. bears East 2408.0'

Corner lies on South end of
cat road.

Witness: R. G. Boyd.


John H. Markham, Jr.

Work done for Stoman Lbr Co.

✓✓ C. S. File No. 42/391-44