

Sept 20, 1960
1/4 corner West Section 1 & 12

T 315 RAW W.N.

At cor. pt. set 1/2" x 24" IR

From which

36" Fin bears S54E 2.0' mhd. 1/165 B.T.


44" Fin bears N88W 20.0' mhd. 1/165 12 B.T.

28" Fin bears N69W 26.0' mhd. 1/165 1 B.T.

N.W. Cor. 12 bears West 1318.0'

North 1/4 cor. 12 bears East 1318.0'

Witness: R.G. Boyd

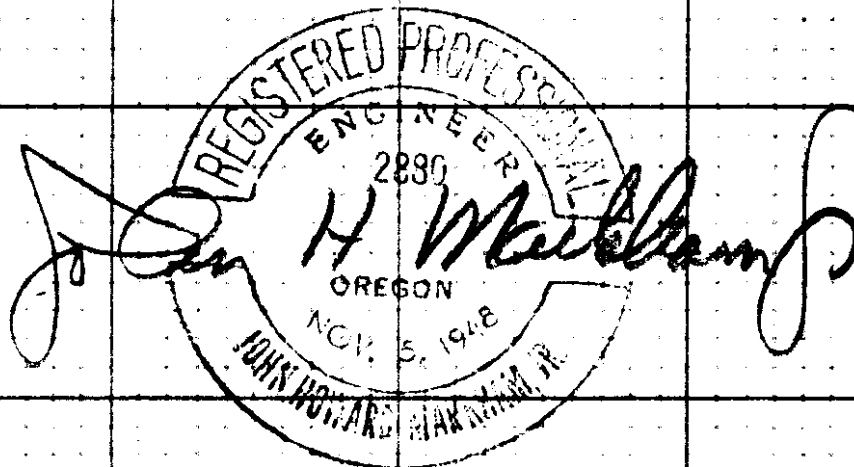

C. S. File No.

42/396⁵

Work done for Storr-Lock Co.