

Sept 29, 1958

South $\frac{1}{4}$ Corner Section 34,
T30S, R3W, W.M. as det. by O.B.T.
28" Maple bears $S66^{\circ}E$ 6.0' dist.
O.B.T. found scribe.

24" Fir $N54^{\circ}W$ 31.0' dist. O.B.T.
At corner point set $1 \times 30^{\circ}$ I.P.
from which


24" Maple bears $N77^{\circ}E$ 53.0' dist.
mkd. $\frac{1}{4}$ S 34 B.T.

18" White Fir bears $S73^{\circ}W$ 16.0' dist.
mkd. $\frac{1}{4}$ S 34 B.T.

Sec. Cor. A3 T31S R3W bears
West 441.5' dist.

Stouts Creek bears East 520.0'
Road bears East 590.0'

Witness:
R. G. Boyd

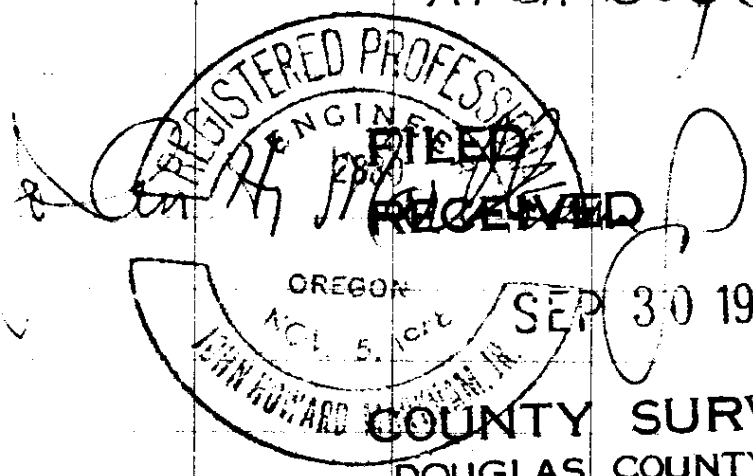

COUNTY SURVEYOR
DOUGLAS COUNTY, ORE.

Work done for Stomar Lbr. Co.

C. S. File No. 42/392²