

Oct. 7, 1958

S.E. Cor. Sec. 34, T30S R3W, W.1/4  
as det. by O.B.T. 5

42" Fir bears N74½°E 45.2'  
dist. O.B.T. - I remarked 535 B.T.

La. Stump bears N50W 4.6' O.B.T.

10" La. Snag down bears S12°E  
22.0' O.B.T. fd. scribe.

At corner point set ¾" x 24" P.  
from which

10" Fir bears N69°E 35.7' dist.  
mkd. 535 B.T.

7" La. bears N79°W 10.5' dist.  
mkd. 534 T30S R3W B.T.

20" La. bears S8°W 22.5' dist.  
mkd. 53 T31S R3W B.T.

24" La. bears S36°E 18.0' dist.  
mkd. 53 T31S R3W B.T.

Corner lies squarely on top  
of ridge


South ¼ cor. 34 bears West. 256 A.S.

Witness:

R. G. Boyd

G.S. File No. 42/392-3

OVER ✓✓

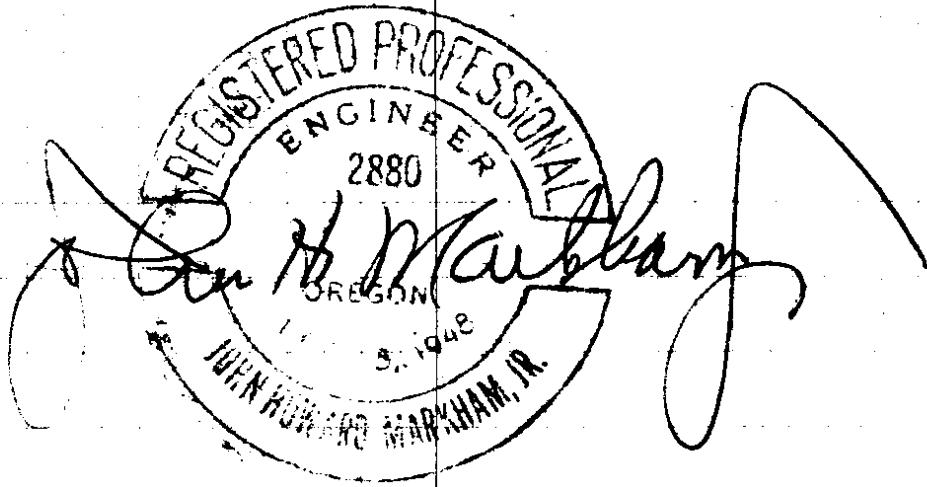

FILED  
RECEIVED

OCT 2 1958

COUNTY SURVEYOR  
DOUGLAS COUNTY, ORE.

Work done for Stroman Lbr Co.