

Oct. 27, 1958

South  $\frac{1}{4}$  Corner 31 (only) T315  
R2W. W.M. as det. by O.B.T.s  
26" Fir wind fall bears N79W  
34.4' dist. O.B.T. fd. scribe.

22" Alder N14E 61.4' O.B.T.

At corner point set 1x30" I.P.

from which

10" Hemlock bears N27W 8.2'  
dist. mkd.  $\frac{1}{4}$ S 31 B.T.

12" Alder bears S55W 3.0'  
dist. mkd.  $\frac{1}{4}$ S 31 B.T.


Corner lies in Creek

Twp. Cor. bears West 575.0'

Road bears East 295.0'

Witness: J. R. Markham

N.W. Cor. 6 bears East 366.0'

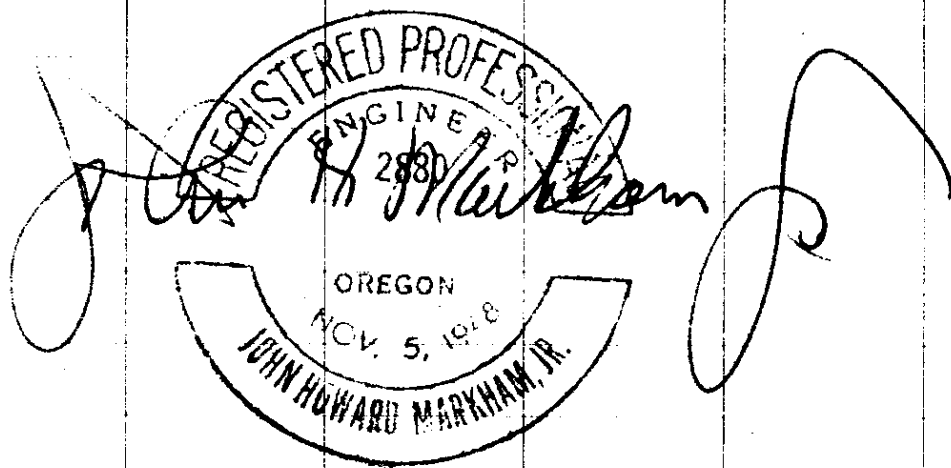

Work done for Stoman Lbr. Co.

✓ C. S. File No. 42/522-14