

Oct. 27, 1958

S. W. Corner Sec. 31, T31S, R2W
W.N. as det. by O.B.T.S

36" Fir bears N43°E 23.0' O.B.T.

24" Fir Stump (Logged) bears

S43°E 23.8' dist. O.B.T.

At corner point set 1' x 30" I.P.
from which

8" Hemlock bears S44°E 28.0'

dist. mkd. S1 T32S B.T.

13" White Fir bears N49°E 45.0'

dist. mkd. S31, T31S R2W B.T.


16" Fir bears S6°30'E 15.4' dist.

mkd. S1 T32S R2W B.T.

Road bears East 75.0' dist.

S.E. Corner 36 bears South 44.0'

Witness: J. R. Markham

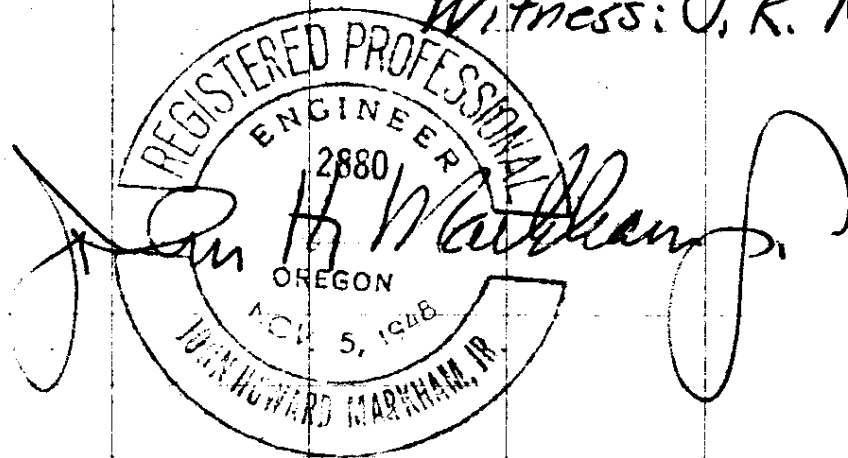

Work done for Stomar Lbr Co.

C. S. File No. 42/332-7