

April 20, 1959

S.W. Corner Sec. 36, T 30 S

- R 3 W W.M. as det. by D. B. T. S
11" Cedar N 57 E 11.3' fd. scribe O.B.T.
13" Cedar N 51 W 12.0' O.B.T.

At corner pt. set $\frac{3}{4}$ " x 30" I.P.
from which


14" La. S 80 E 23.0' mkd. S 2 B.T.

12" La. N 77 E 33.0' mkd S 36 T 30 S R 3 W ^{B.T.}

- 10" Cedar N 7 E 44.4' mkd. S 36 B.T.

12" La. bears N 75 W 44.4' dist
mkd S 35 T 30 S R 3 W B.T.

Witness: R. G. Boyd.

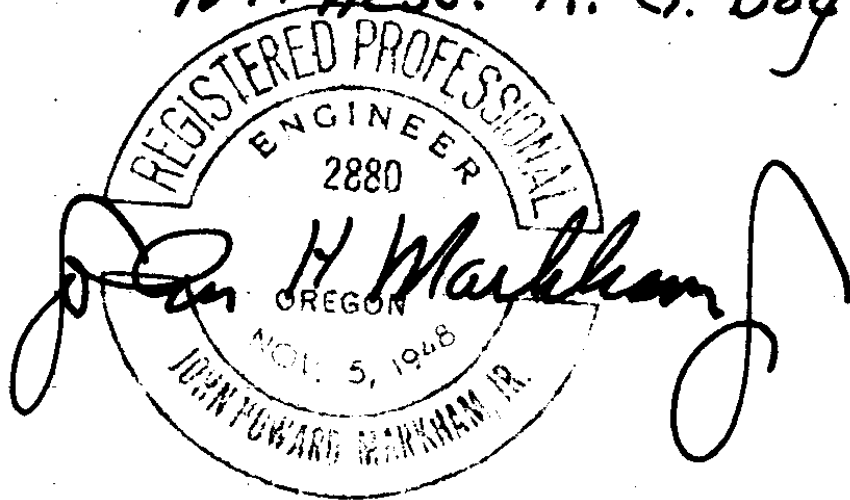

Work done for Stoman Lbr. Co.
✓ C. S. File No. 42/392-12