

Sept. 17, 1959

Center of NW  $\frac{1}{4}$  Section 12  
T31S R3W W.M.

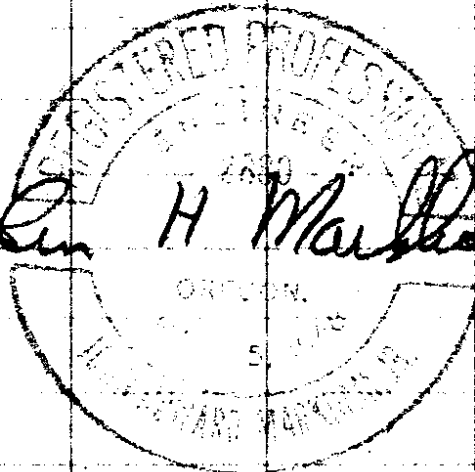
At corner point set  $\frac{3}{4} \times 30$ " I.P.  
from which

9" Yew bears S22W 19.8' mhd.  $\frac{1}{16}$ S12 B.T.

5" Fir bears N29E 10.5' mhd.  $\frac{1}{16}$ S B.T.

11" Cedar bears N30E 17.3' mhd.  $\frac{1}{16}$ S12X B.T.

Witness: R. G. Boyd

  
John H. Matheson

Work done for Stoman Lbr Co.

V.C.S. File No. 42/392-22