

Sept. 17, 1959

$\frac{1}{16}$ section corner East Sec 1 & 12
T 31S R 3W W.M.

At midpoint set 5"x8"x12" stone
from which


8" Hemlock bears S77E 5.5' mkd $\frac{1}{16}$ S 112 B.T.

20" Fir bears S22E 9.5' mkd $\frac{1}{16}$ S 1 X B.T.

Closing Cor 1 & 12 bears East 1326.0'

$\frac{1}{4}$ Cor $\frac{1}{12}$ bears West 1326.0'

Witness R. G. Boyd

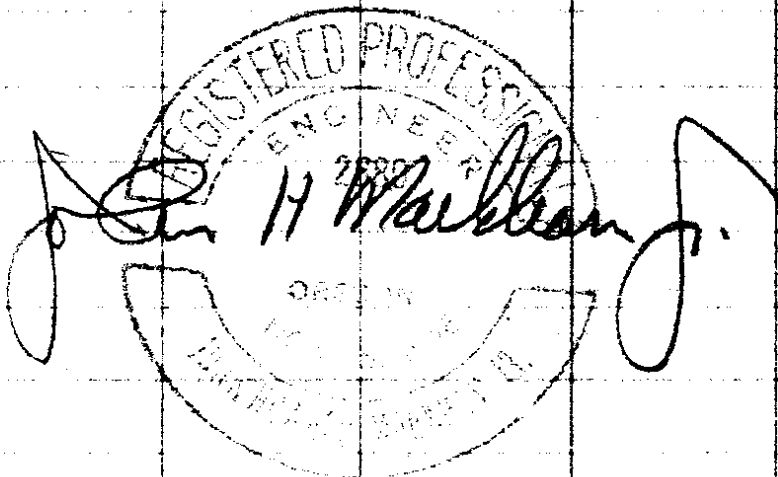

Work done for Stoman Lbr Co.

V.C. E. No. 42/392-27