

Sept. 17, 1959

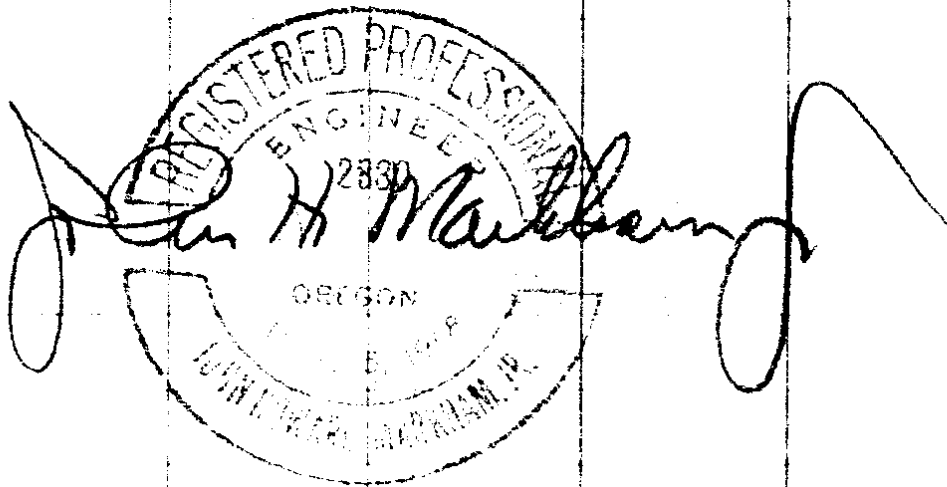
Center N.E. 1/4 Section 12, T31S
R3W, W.N.

At cor. pt. set 2" x 2" wood Post
from which

16" Pine bears N34W 8.2' dist.
mkd. 1/165 12 B.T.

16" Pine bears N43W 14.7' dist.
mkd. 1/165 12 B.T.

Witness: R. G. Boyd


REGISTERED PROFESSIONAL
ENGINEER
2830
JOHN H. MARKHAM
OREGON
JULY 1958
TOWN OF SEASIDE, OREGON

Work done for Storer Lbr. Co.

C. S. File No. 42/392-29