

Sept. 29, 1957

1/4 Corner 11 & 14, T31S R3W  
W.N. was det. by O.B.T.  
5" Fir uproot bears N72E  
19.8' O.B.T. ~~and~~ scribe.

At corner point set 3/4" x 30" I.P.  
from which


13" Fir bears S67°W 16.5' dist.  
mkd. '14514 B.T.

8" Fir bears N38W 13.0' dist.  
mkd. '14511 B.T.

8" La. bears N34E 13.5' dist.  
mkd. '14511 T31S R3W B.T.

16" Alder bears N55E 46.0' dist.  
mkd. '14511 B.T.

Creek bears East 40.0'  
Witness: R. G. Boyd

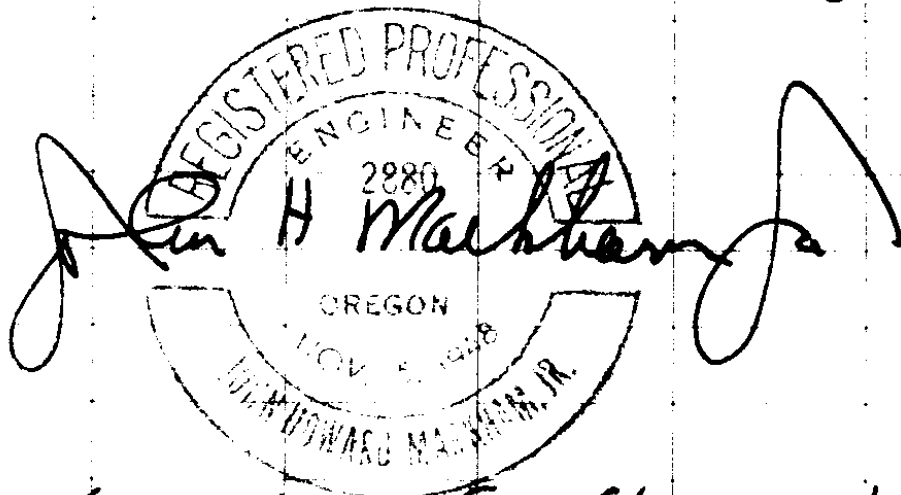

Work done for Stama Lbr 6.

C. S. File No. 42/392-30