

Sept. 8, 1959

1/4 corner 13 & 14 E3/5, R3W

W.M. as det. by [redacted] T.S.

14" Fir N56E 15.8' O.B.T. fd scribe.

12" Fir N74W 8.6' O.B.T.

At corner point found 12" Fir
mkd. on West face & set 3/4" x 30" I.P.

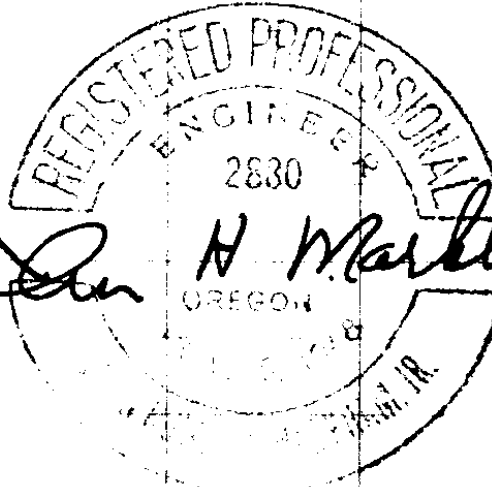
from [redacted]

36" Cedar bears S13E 21.5'
dist. mkd. 1/4 s 13 R3W B.T.

12" Fir bears S74E 24.0' dist.
mkd. on bark 1/4 s 13 B.T.

Corner lies on top of side ridge

Witness: R. G. Boyd


John H. Markham

Work done for Stoman Lbr Co.

C. S. File No. 42/392