

Oct. 26, 1959

Section Corner 17-18-19-20

T315 R3W W.M. as det. by
O.B.T.

13" Dead La. Snag ~~to~~ bears?

530W 18.5' O.B.T.

At corner point set
1 1/4" x 36" I.P.

from which


30" Fir bears S20E 14.5' dist.
mkd. S20 R3W B.T.

24" Fir bears S9°W 15.0' dist.
mkd. S19 B.T.

6" Maple bears N82W 8.0'
dist. mkd. S18 B.T.

8" Fir bears N43E 18.5'
dist. mkd. S17 T315 B.T.

Witness: R. G. Boyd

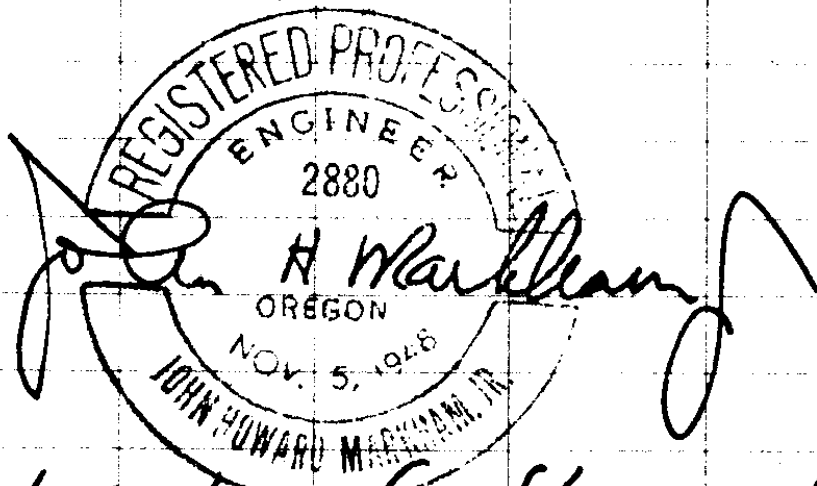

Work done for Homer L. G.

U.S. File No. 42/392-33