

Nov. 4, 1959

1/4 Corner 19-20 T315 R3W
W.N. as det by O.B.T.S

40" Fir Snag S 57E 22.4' O.B.T.

At corner point fd. 1" x 30" I.P.
from which

16" La. bears N89E 21.7' dist.
mkd. '14520 B.T.

13" Fir bears N10E 16.0' dist.
mkd. '14519 B.T.

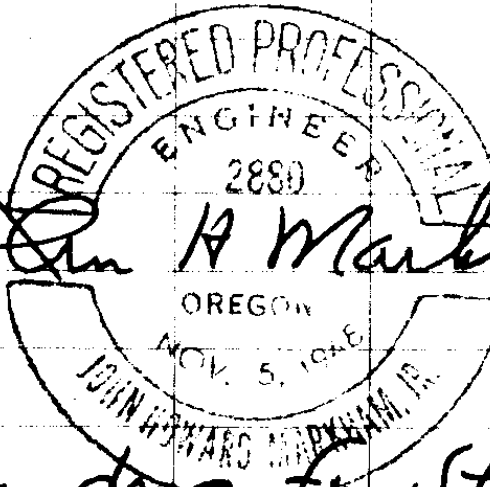
32" Cedar bears S5W 4.4'
dist. mkd. '14519 B.T.

5" Fir bears N75W 13.8' dist.
mkd. '14519 B.T.

24" Fir bears West 43.8' dist.
mkd. '14519 G.S. B.T. SEE OTHER SIDE.

Road bears North 210.0' dist.

Witness: O.A. Keatley


John A. Markham

Work done for Stoman Lbr. Co.

(OVER) C.S. File No. 42/392

Some one had renewed
this cor. before but not
recorded their notes.
Two of the new B.T.S
were theirs

FILED
RECEIVED

NOV 17 1959

COUNTY SURVEYOR
DOUGLAS COUNTY, ORE.