

Nov. 4, 1957

Section Corner 16-17-20-21

T315 R3W as det. by O.B.T.S

30" Fir S44E 36.3' O.B.T.

42" Fir S75E 54.0' O.B.T.

38" Fir Stump (logged) S41W 13.5' O.B.T.

11" La. N69W 18.5' O.B.T.

I rescribed 517 T315 R3W B.T.

At cor. pt. fd. stone & set  $1\frac{1}{2} \times 48"$   
from which !P.


12" La bears S59W 3.5' dist.  
mkd. 520 R3W B.T.

7" Cedar bears S79E 8.5'  
dist. mkd. X 521 X B.T.

7" Cedar bears N12E 38.5'  
dist. mkd. 516 R3W B.T.

~~4" Cedar bears N5E 6.5'~~

Witness: O. A. Keatley

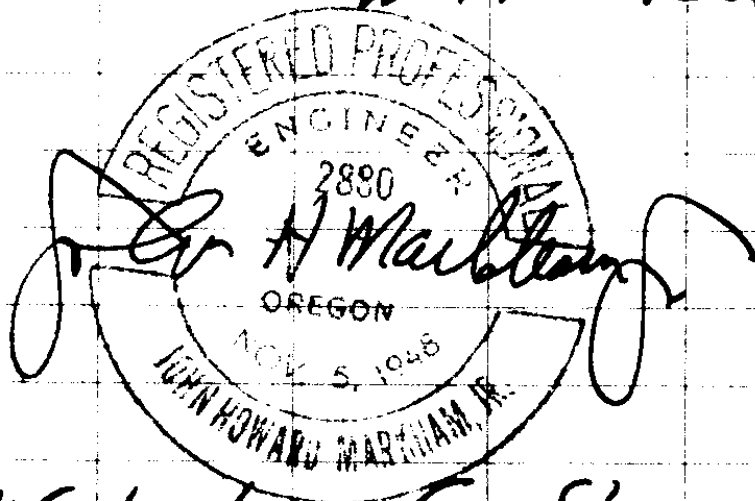

Work done for Stoman Lbr Co.

C. S. File No. 42/392-25