

Nov. 4, 1959

1/4 corner 20-29 T315

R3W W.M.

At corner point found
25" Fir stump & scribed wood
post. I set 1 1/4" x 36" I.P.

from which

14" Cedar bears S53E 37.0'
dist. already scribed

1/4 S 29 C.S. B.T.

22" Lg. bears S62E 10.0' dist.
mkd. 1/4 S 29 B.T.


10" Lg. bears N67E 26.0'

dist. mkd. 1/4 S 20 T315 R3W B.T.

Road bears East 70.0' dist.

Witness: O.A. Keatley

4" Cedar N55E 6.5' 1/4 S 20 B.T.

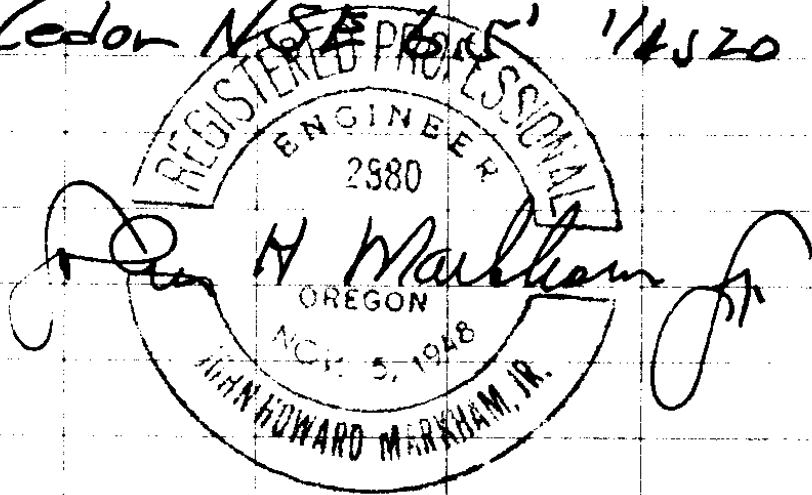

Work done for Stamer Lbr. Co.

(OVER) S. File No. 42/392-37

Some one has renewed
this corner but not
recorded their notes,
as you will note by one
of the new B.T.S.

J.M.

FILED

RECEIVED

NOV 17 1953

COUNTY SURVEYOR

DOUGLAS COUNTY, ORE.