

Nov. 16, 1959

Corner 7-18 T315 ~~R211~~
W.M. as det. by O.B.T.S.

7" La Snag N20E 19.8' O.B.T.

At corner point found 20"
Fin chopped out North face &
fd. scribe: from which
16" Fin bears N42W 18.0' dist.

mkd. '1457 B.T.

8" Fin bears N14E 6.0' dist.

mkd. '1457 x B.T.

10" Fin bears N40E 13.5' dist.

mkd. '1457 B.T.


14" Fin bears S86E 14.5' dist.

mkd. '145.18 B.T.

Corner lies on very steep North
face approx. 120' South of Creek

Sec. Cor. bears S82°45'W

Sec. Cor. bears Due East (20°00'Var)

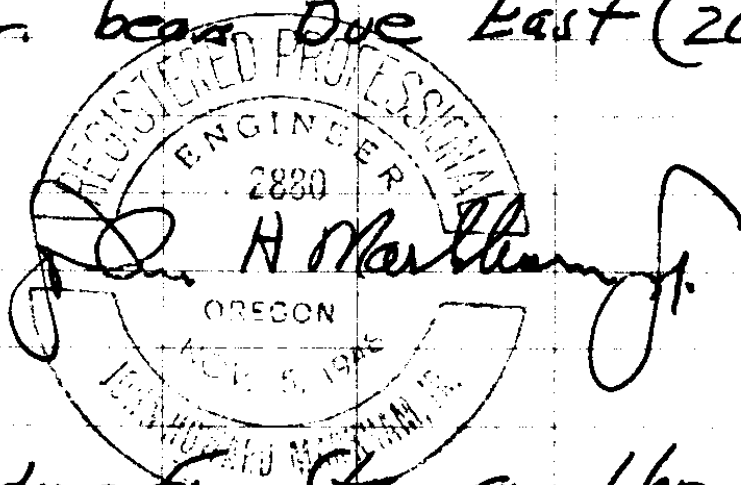

Work done for Stroman Lbr. Co.

✓ V.C.S. No. 42/392-38