

Nov. 16, 1959

Section Corner ~~7-8-17-18~~ 7-8-17-18

T315 R3W. W.M. as det. by O.B.T.S.

11" Lq. N27W 44.0' dist. O.B.T. fd. scribe

16" Lq. N71E 5.3' O.B.T. I rescribed

R3W S8 T315 B.T.

12" Lq. S53W 9.3' O.B.T. I marked S18 B.T.

At cor. pt. fd. stone & set 3/4 x 30" I.P.

from which

8" Chip. bears NNW 27.0' dist.

m kd. S7 R3W B.T.

12" Fir bears N53W 17.9' dist.

m kd. S7 R3W B.T.


14" Fir bears S60E 23.7' dist.

m kd. S17. B.T.

12" Lq. bears S33E 17.0' dist.

m kd. S17 T315 R3W B.T.

Witness: R.G. Boyd

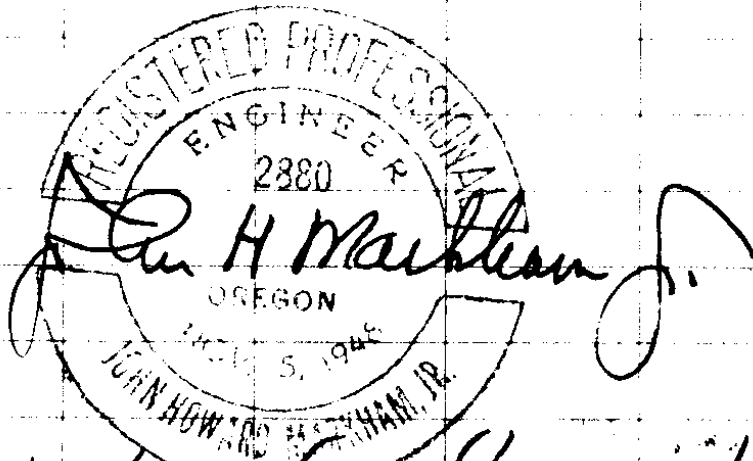

Work done for Storer Lbr. Co.

C. S. File No. 42/392-39