

Nov. 18, 1959

Section Corner 10-11-14-15

T315 R3W W.M. as det. by O.B.T.

40" Fir S41E 38.3' O.B.T. fd. scribe.

36" Fir Snag N60W 6.6' O.B.T.

16" La. N49E 31.4' O.B.T. - I

rescribe s11 B.T.

At cor. pt. fd. stone & set $\frac{1}{2}$ " x 24" I.P.

from which


4" Pine S5E 21.6' S14 B.T.

5" Live Oak S37E 28.0' S14 B.T.

4" Chip. S86W 10.1' S15 B.T.

13" La. N15E 5.6' S11 B.T.

Witness: O.A. Keatley

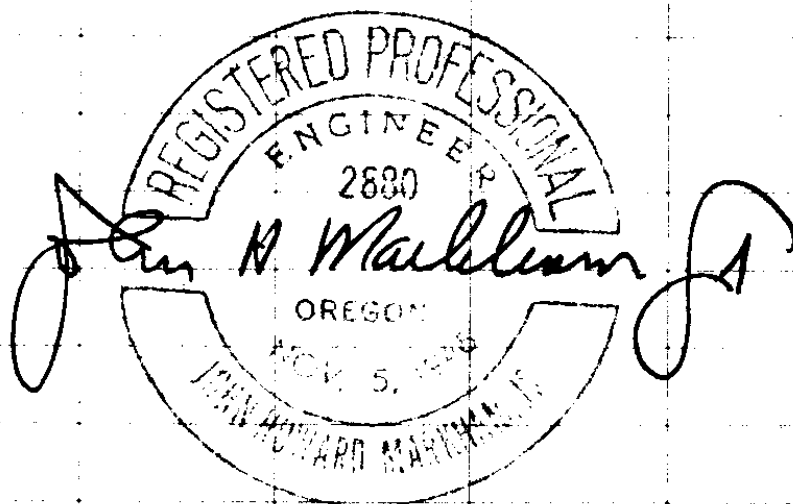

Work done for Stoman Lbr Co

C. S. File No. 12/392-40