

Nov. 18, 1959

1/4 Corner 14-15, T315 R3W

● W.M. as det. by O.B.T.S.

36" Fir Snag S34E 9.2' O.B.T.

40" Cedar N67W 31.6' D.B.T.

● At corner point found large  
stone & set  $\frac{1}{2}$ " x 24" I.P.  
from which


● 4" Fir S72E 25.0' mhd. 1/45 14 B.T.

6" Fir S54W 18.6' 1/45 15 B.T.

8" Fir N64W 19.1' 1/45 15X BT

9" Fir N28W 33.8' 1/45 15 B.T.

Witness: D.A. Keatley

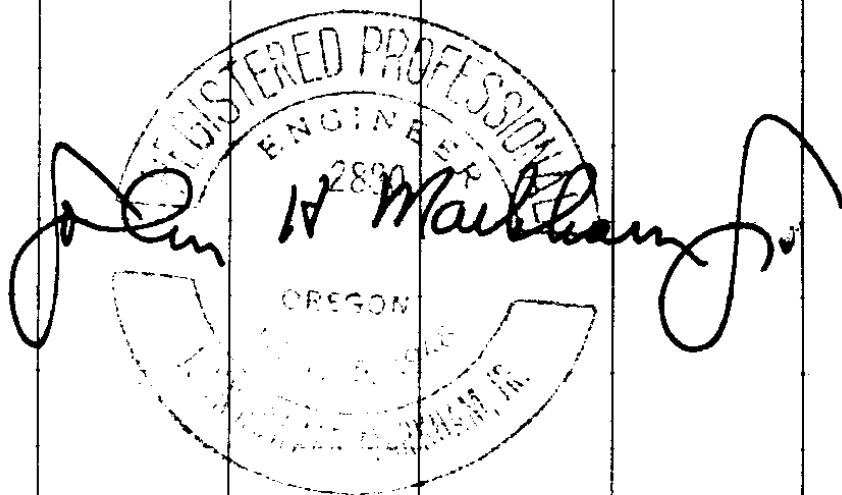

Work done for Stoman Lbr. Co.

C. S. File No. 42/392<sup>A</sup>