

Nov. 23, 1959

(South)

1/16 corner on Range Line

Sec. 7 & 12 T315 R2 & 3 W

At midpoint set 1/2" x 40" I.P.

from which

24" La. N67E 56.6' 1/16 S 12 B.T.

8" La. N17E 32.0' 1/16 S 12 B.T.


10" Fir S81E 49.2' 1/16 S 12 B.T.

12" La. S89W 22.0' 1/16 S 12 B.T.

East 1/4 Sec. 12 bears North 1329.0'

S.E. Cor. 12 bears South 1329.0'

Witness: R. G. Boyd

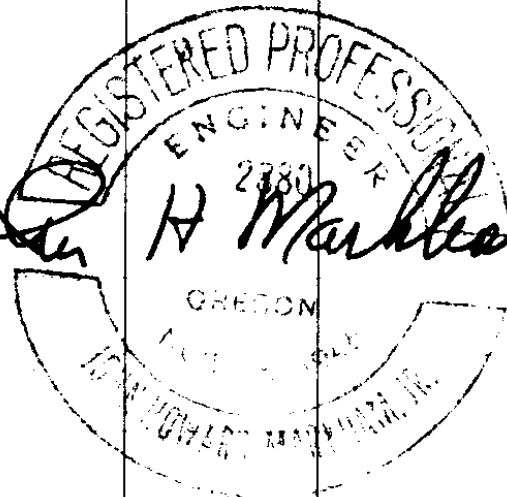

H. Markham

Work done for Stoman Lbr Co.

C. S. File No. 42/392