

Nov. 23, 1959

1/16 Corner (C.S.) Section

● 12 T315 R3W W.M.

At cor. pt. set I.P.

from which

● 20" Fil 579E 38.0' 1/16512 C.S. B.T.


20" Fil 523E 37.0' 1/16512 C.S. B.T.

14" La. 536W 17.4' 1/16512 C.S. B.T.

● South 1/4 Corner Sec. 12 bears South

~~1329.0'~~ 1329.0' dist.

Witness: R. G. Boyd

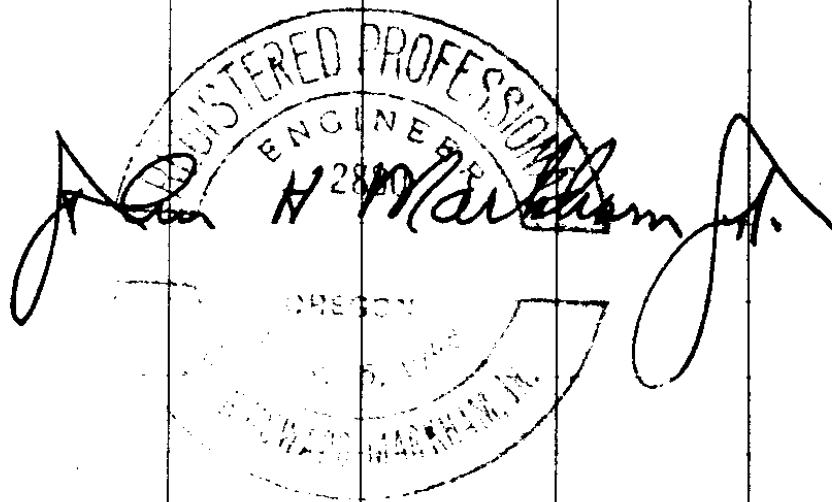

Work done for Stoman Lbr Co.

C. S. File No.

42/392-46