

Nov. 23, 1959

East 1/4 Corner Section 12

- only T31S. R3W. W.1/2. as det. by O.B.T.
- 28" Fir S63W 5.3' O.B.T.

At corner point found stone


- & set 1/2" x 40" I.P.

from which

- 8" Hemlock S10W 10.0' 1/4S12 B.T.
- 6" Hemlock S33E 22.6' 1/4S12 B.T.
- 8" Hemlock N74E 16.8' 1/4S12 B.T.
- 6" Fir N62E 7.6' 1/4S12X B.T.

Witness: R.G. Boyd

O.A. Keightly

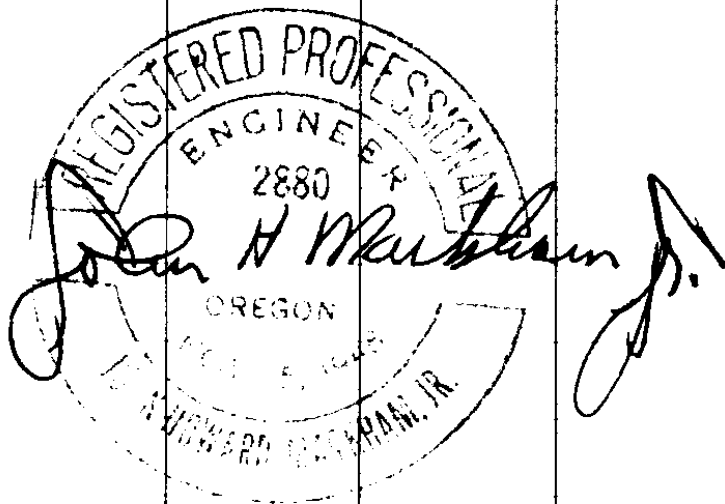

Work done for Stoman Lbr. Co.

C. S. File No.

42/392-47