

Dec. 16, 1959

1/4 Corner 23-24 T315 R3W
W.M. as det. by O.B.T.

14" La. N32W 32.3' O.B.T. - I
rescribed '4523 T315 R3W B.T.

At cor. pt. fd. stone & set
1/2" x 30" I.P. from which

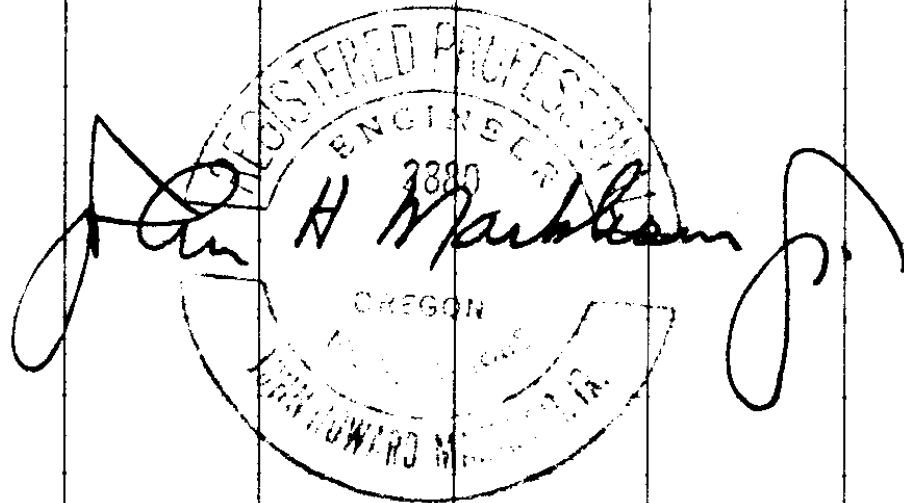
7" La. N52E 12.0' '4524 R3W B.T.

15" Pine East 7.0' '4524 B.T.

8" La. S67E 11.7' '4524 B.T.

7" La. S35W 5.0' '4523 R3W B.T.

Witness: D. A. Keatley


REGISTERED PROFESSIONAL
ENGINEER
2880
OREGON
JOHN HOWARD MARKHAM

Work done for Stoman Lbr. Co.

C. S. File No.

42/392-49