

May 17, 1960

1/4 Corner 4-5 T315 R3W
as det. by O.B.T.S. (Gov't notes
had East & West turned around
on both O.B.T.S.)

12" La. S72E 19.8' O.B.T. - I
rescribed '145 4 T315 R3W B.T.
15" Fin S15W 10.6' O.B.T.


At corner pt. fd. original stone.
from which

38" Fin N68W 25.7' dist. mkd
'145 B.T.

3" Chip. bears N61W 12.2'
dist. mkd. '145 B.T.

6" La. bears N6W 5.5' dist.
mkd. '145 B.T.

Witness: R. G. Boyd
O. A. Keatley

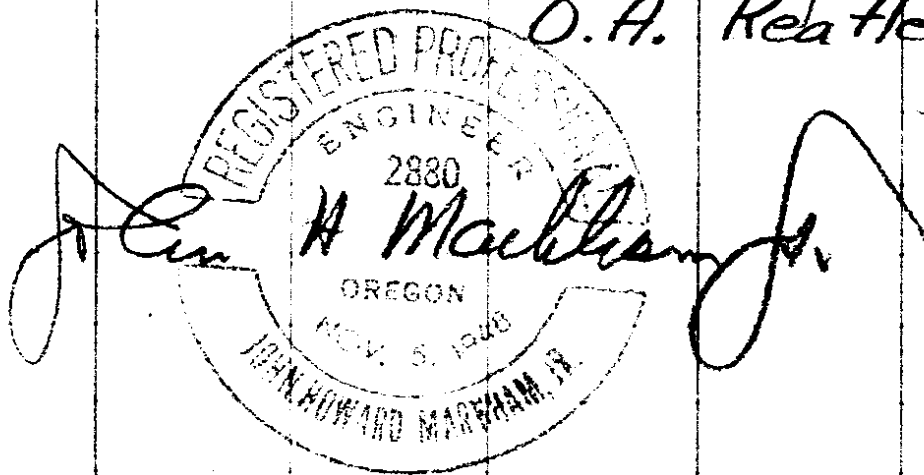

Work done for Stinson Lbr. Co.
✓ C. S. File No. 42/392 '5