

June 9, 1960

S.E. Corner Section 32,
T30S R3W W.M. as det. by O.B.T.

22" Dead fir snag N75E 8.6'
dist. O.B.T. found scribe.

Both other B.T.s burnt off
at ground level.

At corner point found stone
and set $3\frac{1}{4} \times 30$ " I.P.

from which


20" Cedar N7E 6.0' S33 R3W B.T.

20" Cedar N5W 22.0' S32 R3W B.T.

20" Cedar S35W 34.0' S5 T31SX B.T.

16" Cedar S1W 34.7' S5 T31S R3W B.T.

Witness: R. G. Boyd

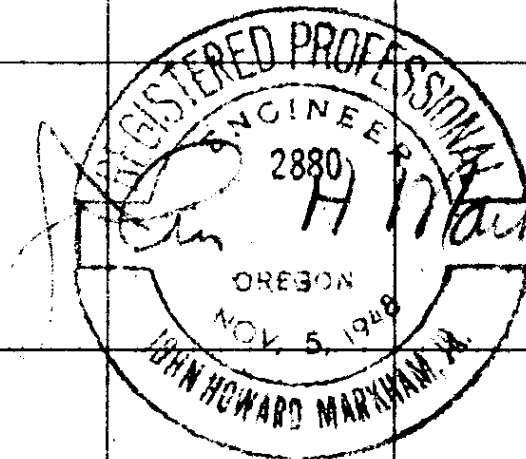

Work done for Stroman Lbr. Co. '55

C. S. File No. 427392