

June 9, 1960  
1/4 Corner 32-33 T305 R3W

W.M. as det. by O.B.T.S.

20" Fir S27E 27.1' O.B.T.

16" Fir S19W 13.9' O.B.T.

At corner point set 3/4" x 30" I.P.


from which  
50" Cedar S78E 29.5' 1/4S 533 B.T.

8" Fir N42W 10.9' 1/4S 32X B.T.

7" Fir N40E 15.3' 1/4S 33 B.T.

12" Lg. S88E 32.6' 1/4S 33 T305 R3W B.T.

Witness: R.G. Boyd

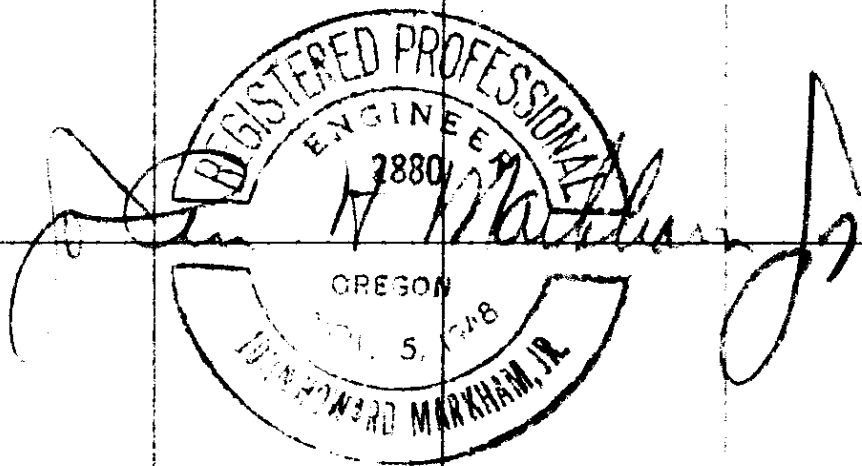

Work done for Roman Lbr. Co. #

C. S. File No. 42/372