

June 9, 1960

Sec. Cor. 28-29-32-33 T305

● R3W W.M. as det. by O.B.T.S.

22" B.O. snag N60E 38.4' O.B.T.

26" Fir windfall S70W 19.8' O.B.T. f. scribe

24" La N82W 30.1' f. scribe O.B.T.

16" Cedar uproot S89E 17.8' O.B.T.

At corner point found stone &  
set 3/4" x 30" I.P.

from which


30" La N70W 36.0' S29T305 R3W B.T.

● 24" Cedar S76E 27.0' S33 R3W B.T.

● 5" Fir S55E 11.8' S28 B.T.

5" Chip S47W 9.7' S32 B.T.

Witness: R. G. Boyd

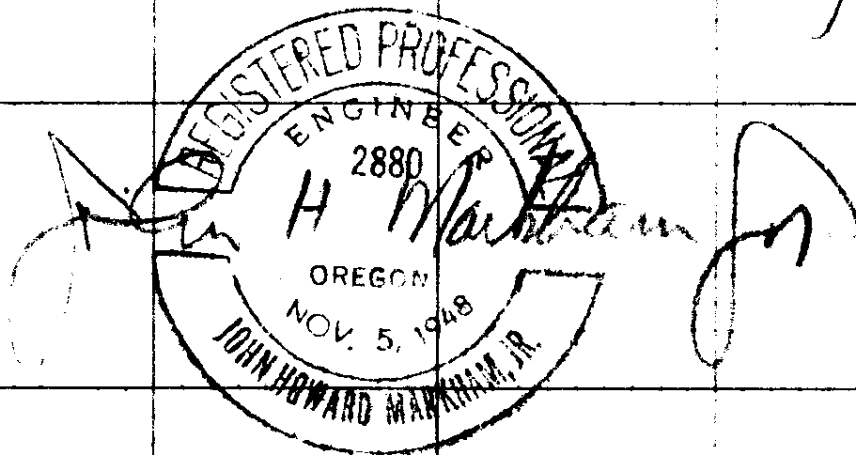

Work done for Stoman Lbr Co. S1

C. S. File No. 42/392