

June 9, 1960  
1/4 Corner 29-32 T30S R3W  
as det. by O.B.T.s

20" Fir stump (logged) N70E  
15.2' O.B.T.

At corner point set 2" x 36"  
truck axle with flange up.  
From which

24" Fir S41E 122.0' 14532 B.T.


14" Fir N73W 59.0' 14529 B.T.

A Good rock road loops the  
corner

Road bears South 35.0'

Road bears East 41.0'

Witness: R.G. Boyd

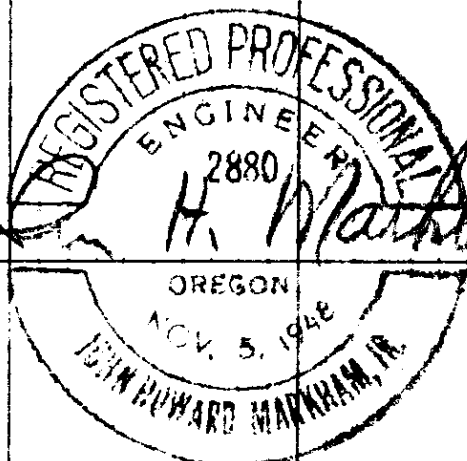

H. Mathman

Work done for Tomian Lbr Co. 58

C. S. File No. 42/392