

June 13, 1960

Sec Corner 29-30-31-32, T305

R3W ds det. by O.B.T.S.

24" Fir S29W 63.0" O.B.T.

30" Fir S70E 12.9' O.B.T. fd. scribe

30" Fir N54E 16.2' O.B.T.

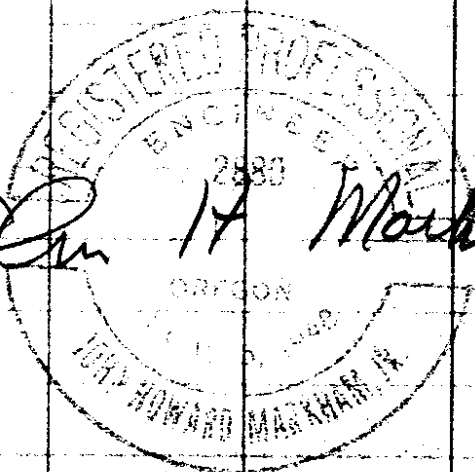
At corner point set $\frac{3}{4}$ " x 30" I.P.
from which

5" Chip. S26W 38.0' mkd. S31 R3W B.T.

12" La. N44W 17.3' mkd. S30 T305 R3W B.T.

12" La. N10E 25.2' mkd. S29 T305 R3W B.T.

Witness: R. G. Boyd


C. H. Markham Jr.

Work done for Stoman Lbr Co. ^{SR}
✓ ✓ C. S. File No. 42/392