

July 27, 1960

S.W. Corner Section 32

● T305 R3W as det. by O.B.T.  
32" Fir S72E 30.0' O.B.T.  
found scribe.

9" Fir Snag N28E 22.1' O.B.T.  
At corner pt. set 3/4" x 40" LP  
from which

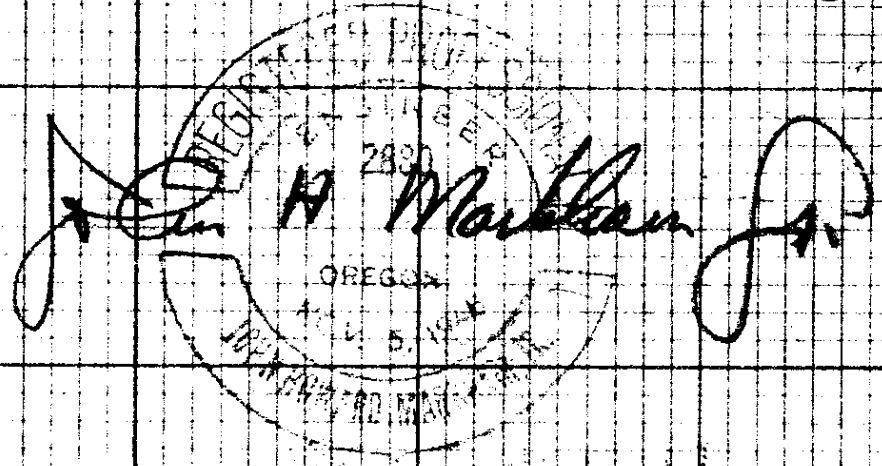
30" La. bears N88E 47.0' dist.  
mkd. S32 T305 R3W B.T.

9" La. N58W 19.0 dist. mkd.

S31 T305 R3W B.T.

● 12" La. bears S17W 26.0' dist.  
mkd. S6 T315 R3W B.T.

Witness: R.G. Boyd

  
J. H. Markham Jr.  
OREGON  
Notary Public

Work done for Stone Hill Co. 3  
C.S.F. No. 44/392