

July 27, 1960

North  $\frac{1}{4}$  corner Section 6

(only) T313 R3W


At corner point set.  $2 \times 30''$  IP  
from which

8" Chip N18E 20.0'  $\frac{1}{4}$  56 B.T.

6" Chip S74E 25.0'  $\frac{1}{4}$  56 B.T.

4" Pin S43E 23.8'  $\frac{1}{4}$  56 B.T.

Witness: R. G. Boyd

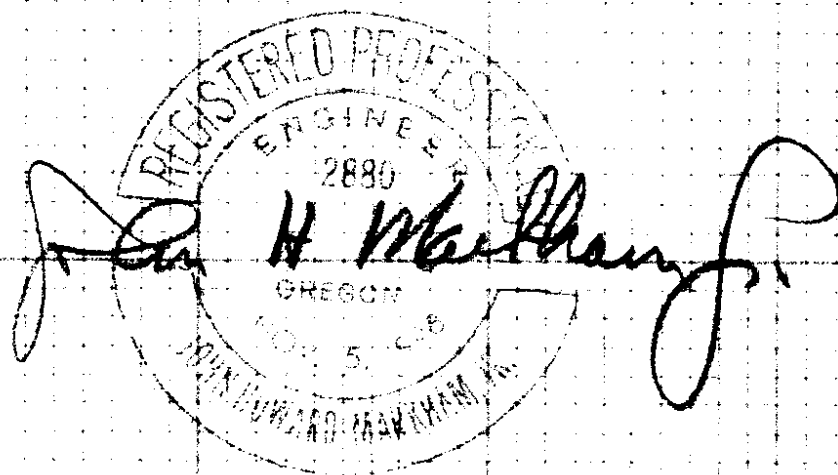

C. S. File No.

42/392

CH

✓ Work done for Homer Lbr Co