

Sept. 15, 1960

1/4 corner 22/27 T305 R3W

● 48 det. by O.B.T.

18" Fir S35E 22.0' O.B.T.

30" Fir Stump (Logged) N65E

20.0' dist. O.B.T.

At cor. pt. set 3/4" x 30" I.P.

from which

40" Fir S35E 32.0' mkd. 1/45 27 B.T.

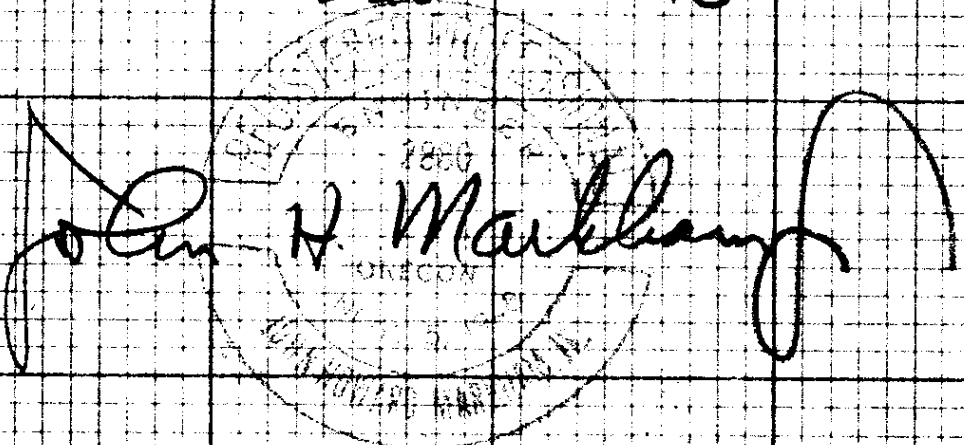
32" Fir S47E 38.0' mkd. 1/45 27 B.T.

● 9" Hemlock S60E 18.0' 1/45 27 B.T.

16" Hemlock N29E 53.0' mkd. 1/45 22 B.T.

Witness: R. G. Boyd

Road bears East 510.0'

John H. Markham

C.S. File No. 12/392

Work done for Starnes Lumber Co.