

Sept. 20, 1960

S.W. Corner Lot 1, Sec. 7,

T315 R3W W.M.

At cor pt. set  $\frac{1}{2}$ " x 24" I.P.

from which

24" Fir bears South 22.0' mkd.

'16512 B.T.


32" Fir bears S54 $\frac{1}{2}$ E 59.7' mkd.

'1657 B.T.

N.W. corner Sec. 7 bears North 1301.5'

West  $\frac{1}{4}$  cor 7 bears South 1301.5'

Witness: R. G. Boyd.

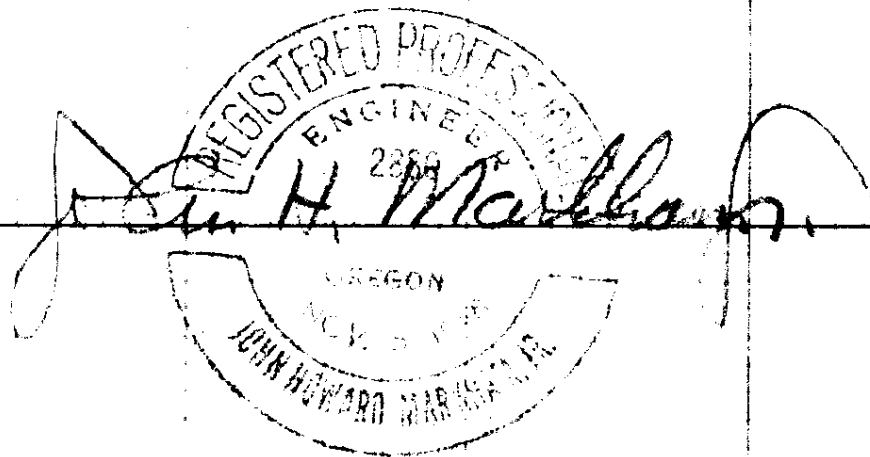

C. S. File No.

42/392-59

Work done for Stoman Lbr. Co.