

Jan. 19, 1961

Sec. Cor. 4-5-8-9, T31S R3W
as det. by O.B.T.S.

30" Cedar N37E 26.4' O.B.T.

30" La. S36W 30.0' O.B.T.

36" Cedar N17W 41.0' O.B.T. fd. scribe

At cor. pt. set 1/2" x 30" IP.

from which

52" Fir bears S30E 33.3' dist.


mkd. S9 T31S R3W B.T.

8" La. bears N87W 8.8' mkd. S8 B.T.

7" La. bears N37W 26.6' dist.

mkd. S5 T31S R3W B.T.

Witness: O. A. Keotley

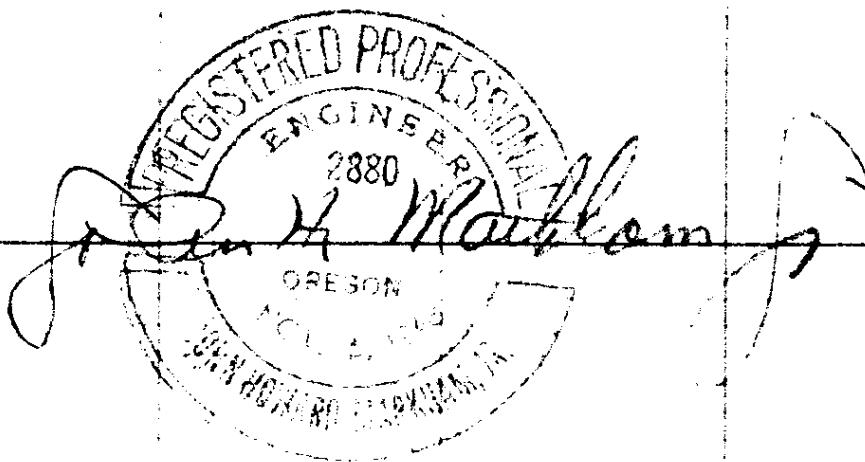

Work done for Stommar Lbr. Co. 12/39/61
W.C.S. F. 12/39/61