


COUNTY SURVEYOR
 DOUGLAS COUNTY

R. 12 W.

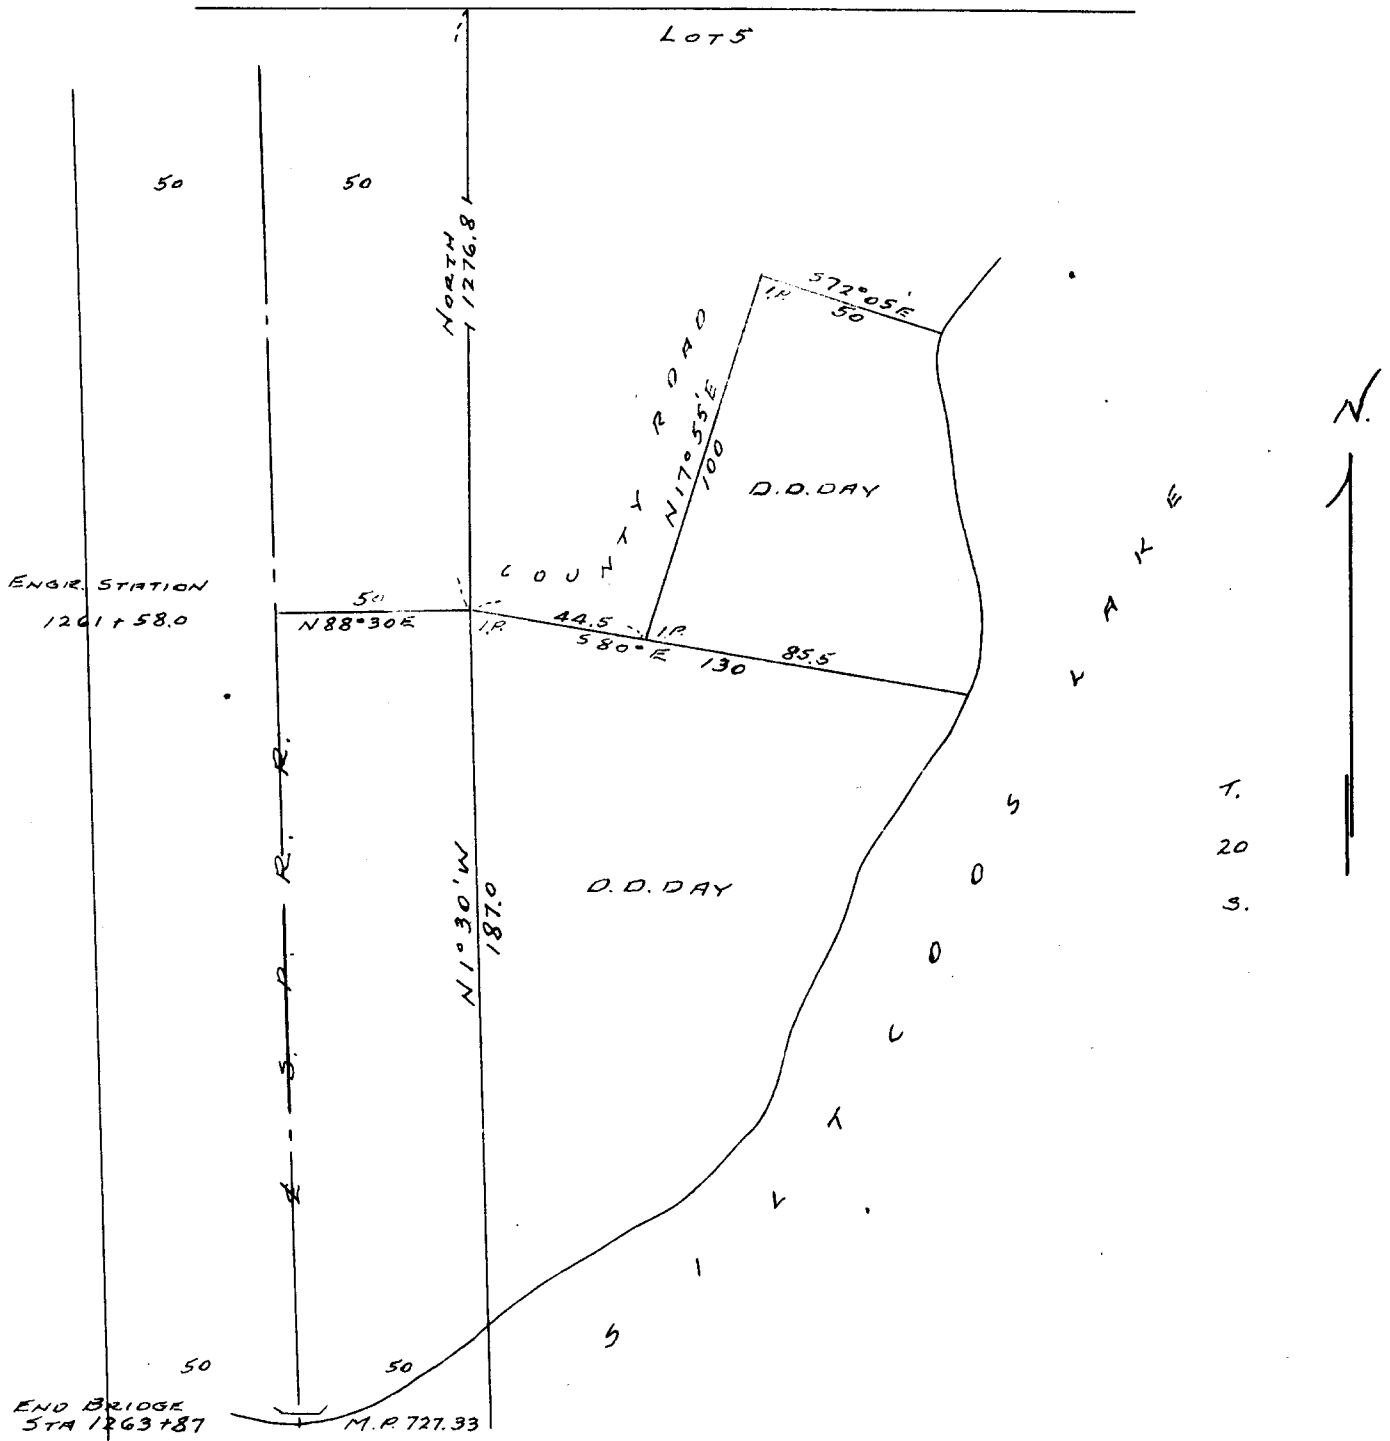

SURVEY
 D. D. DAY
 LOT 5 - SEC. 1
 T20S, R.12W, W.M.
 DOUGLAS COUNTY
 Scale 1" = 50' July '58.

