

ESTABLISHED CORNERS FOR OREGON STATE BOARD OF FORESTRY

North One-Sixteenth corner common to Sections 19 and 20, T22S, R11W, W.M., Douglas County, Oregon.

ESTABLISHED

Set 1 1/2" x 36" galvanized iron pipe with 3" bronze cap marked "OREGON STATE BOARD OF FORESTRY N 1/16 S19 S20 1961 RS359", 30 inches in ground, in mound of stone, and from which a:

49" Fir bears N6°E 44.4 ft.; scribed N 1/16 S20 BT.

30" Double Maple bears N27 1/2°W 29.7 ft.; scribed N 1/16 S19 BT RS359.

State Forestry Department metal location poster on 49" Fir BT.

Set 4" x 4" x 72" white painted Cedar post 2 ft. SE of pipe.

Present and witnessed by S. McCleve, T. South

Established by George E. Shore, Jr. under my direction.  
George E. Shore, Jr., Transitman

\* \* \* \* \*

o

Center North One-Sixteenth corner for Section 19, T22S, R11W, W.M., Douglas County, Oregon.

ESTABLISHED

Set 1 1/2" x 36" galvanized iron pipe with 3" bronze cap marked "OREGON STATE BOARD OF FORESTRY N 1/16 C---C S19 1961 RS359", 33 inches in ground, in mound of stone, and from which a:

Small rock bluff 4' high in center of creek bears S64 1/2°W 20.2 ft.; marked X.

37" Alder bears S67 1/2°E 73.5 ft.; scribed CN 1/16 S19 BT RS359.


State Forestry Department metal location poster on 37" Alder BT.

Set 4" x 4" x 72" white painted Cedar post 1 ft. SE of pipe.

Corner sets on North edge of creek bed.

Dated August 18, 1961

Established by

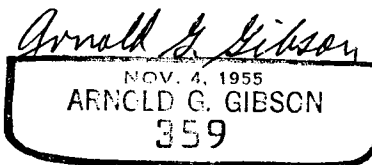

FILED  
RECEIVED

Present and witnessed by G. Shore, S. McCleve, R. Aaserude

SEP 15 1961

COUNTY SURVEYOR  
DOUGLAS COUNTY, ORE.

o ✓

42/403-23