



**Restoration of the Destroyed Corner of
Sections 15, 16, 21, and 22, T 25 S, R 1 E**

This survey was made November 24, 1958 for Mr. Forrest Alberti of Glide, Oregon to replace a monument destroyed by him while logging. The corner of sections 15, 16, 21, and 22, T 25 S, R 1 E, was a 12 inch hemlock which had been tied to a cutting unit boundary by Forest Service surveyors. Although marked to be saved, the tree was destroyed during logging. The Forest Service administrator present then placed a temporary metal pipe in the stump hole. The logger, Mr. Alberti confirmed the location. Blazes still exist intercepting the stump hole from all directions.

A Wild theodolite was used in reestablishing the corner. A pipe 2 inches in diameter and 43 inches long marks the corner. From it: a pipe 2 " by 25" bears N 32* 7' W a distance of 13' 7"; a pipe 1 1/2" by 28" bears N 57* 32' E a distance of 13' 1"; a pipe 1 1/2" by 24 " bears S 66* 6' E a distance of 14' 2"; a pipe 2" by 28" bears S 58* 16' W a distance of 18' 5".

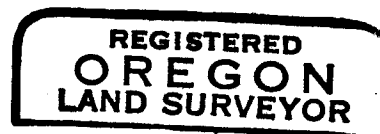

D. G. Heuschkel

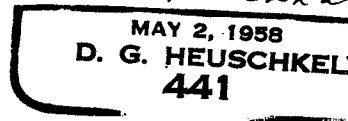

FILED
RECEIVED

DEC 11 1958

COUNTY SURVEYOR
DOUGLAS COUNTY, ORE.

✓✓ C. S. File No. 42/405