


COUNTY SURVEYORS FILE DATA
DO NOT REMOVE FROM OFFICE

R. 1. W

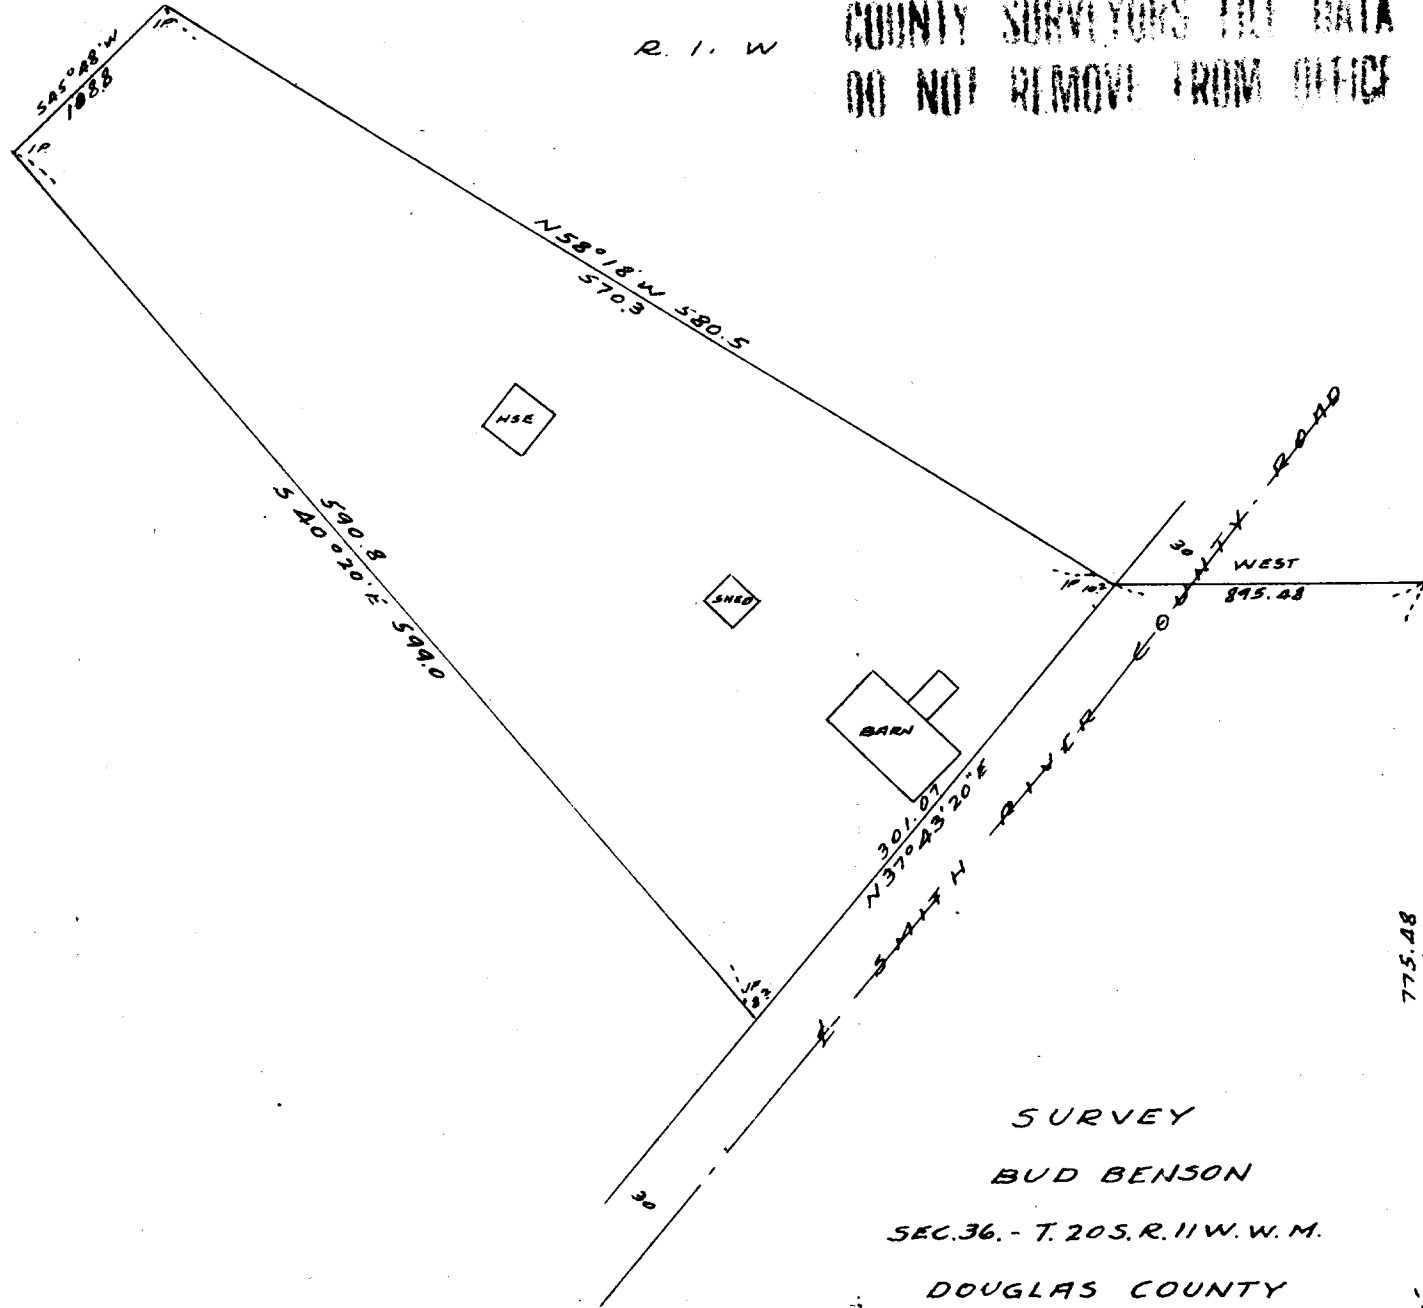

T.
20
S.

SURVEY
BUD BENSON
SEC. 36. - T. 20 S. R. 11 W. W. M.
DOUGLAS COUNTY
Scale 1" = 100' Nov. '58.

775.48
NORTH

36

T.
21
S.

